


I, C.T. DARLEY do hereby certify that this map was made from field notes made during a field survey made by me on April 9, 1955 and that it reasonably represents the location, shape and general features of the constructed works as proposed by the accompanying application.

I, C.T. DARLEY do hereby certify that this map was made from field notes made during a field survey made by me on April 9, 1955 and that it reasonably represents the location, shape and general features of the constructed works as proposed by the accompanying application.

Signed: C. T. Darby

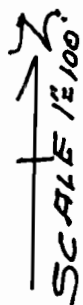

 AREA concerned in Application R25364 + Permit R1103.

Application No. R-29927 & 29928
Permit No. R-1813 & 25089