


T. 1 S. R. 3 W. W.M.

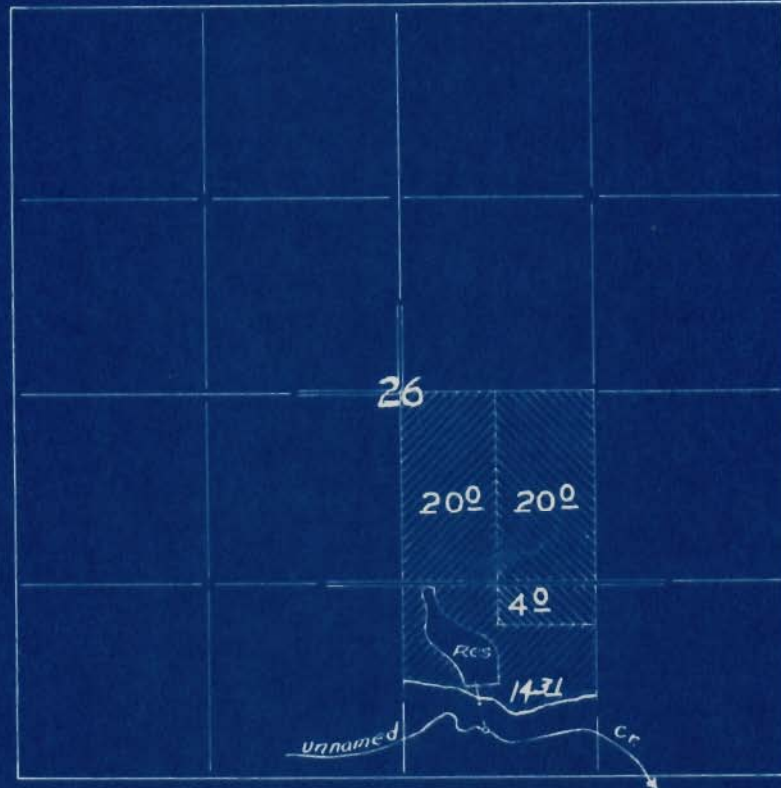


FINAL PROOF SURVEY

R - 27709 UNDER  
27708

R - 1440  
21830

Application No. 29388 Permit No. 23150

 27708  
29388

IN NAME OF

PATRICK J. UNGER

Surveyed 5 - 1 1956 by R.H. WHITBY