


T.38S, R.11 & 11½ E.W.M.

Bush Cr. & Yonna Valley wells

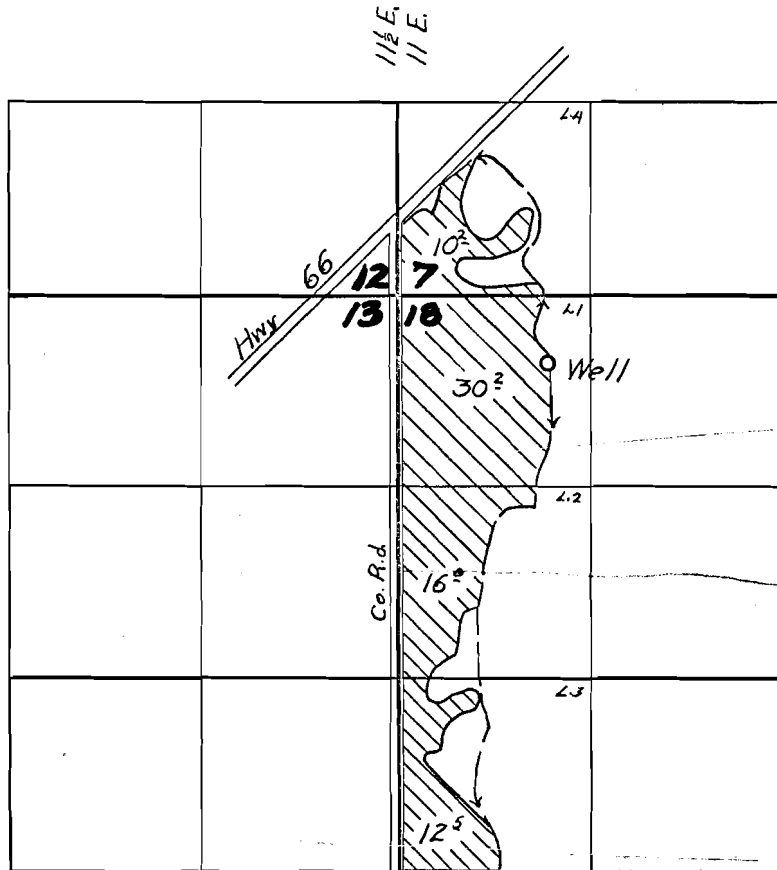

FINAL PROOF SURVEY
UNDER

Application No. U-278 Permit No. U-249
IN NAME OF

Ernest & Martha C. Ritter

Surveyed 15 May 1955, by H.L. Coffman