


31171

# T.36S.R.24E.W.M.

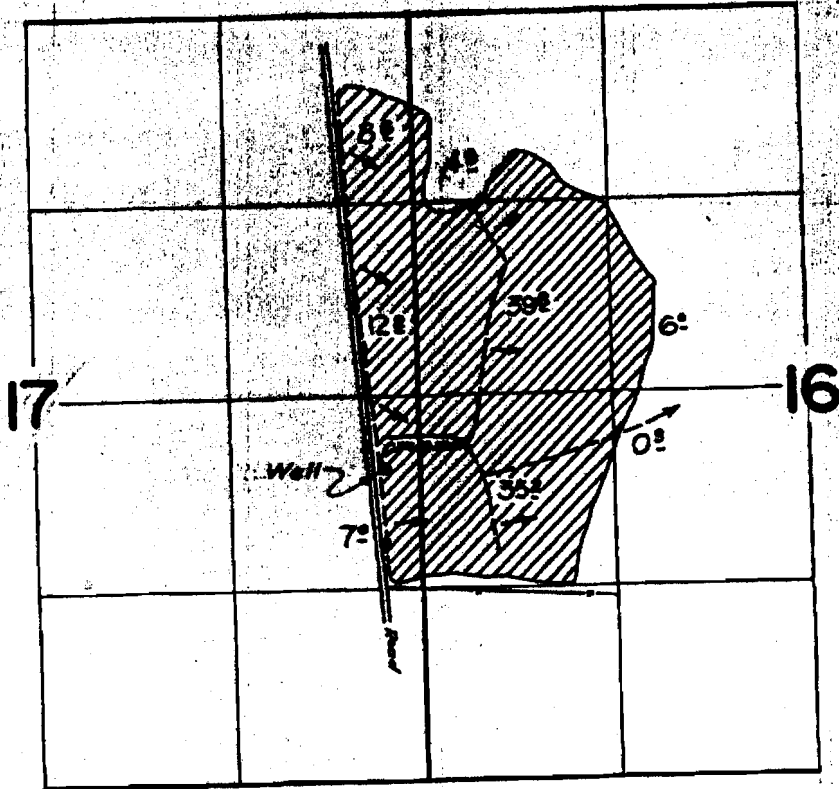

## FINAL PROOF SURVEY UNDER

Application No. U-297... Permit No. U-273...  
IN NAME OF

FITZGERALD BROS.

Surveyed Sept. 14, 1962, by *R. Jackson*