U-299
23382

T. 38 & 39 S. R. 108, 112 E. W.M.

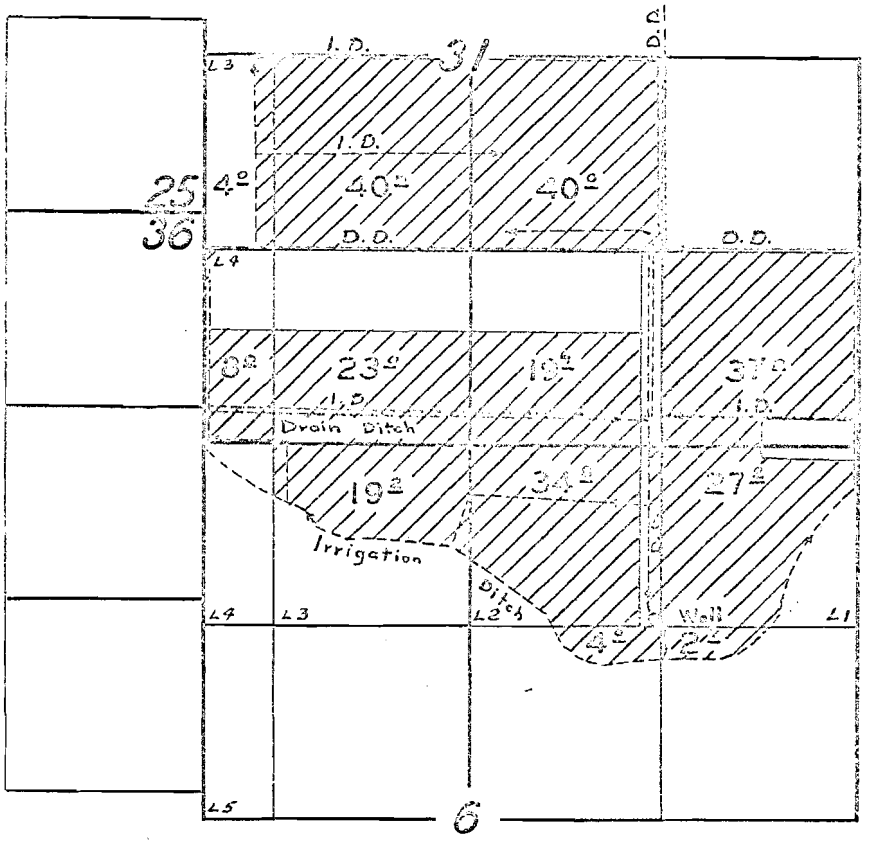

Swan Lake Well

PROOF MAP OF PROOF
UNDER
Application No. U-324 Permit No. U-299
IN NAME OF
EVERETT E. METTLER
Surveyed 17 May 1955, by H.L. Coffman

CNO-GIK-93