


T. 2 S., R. 2 W., W.M.

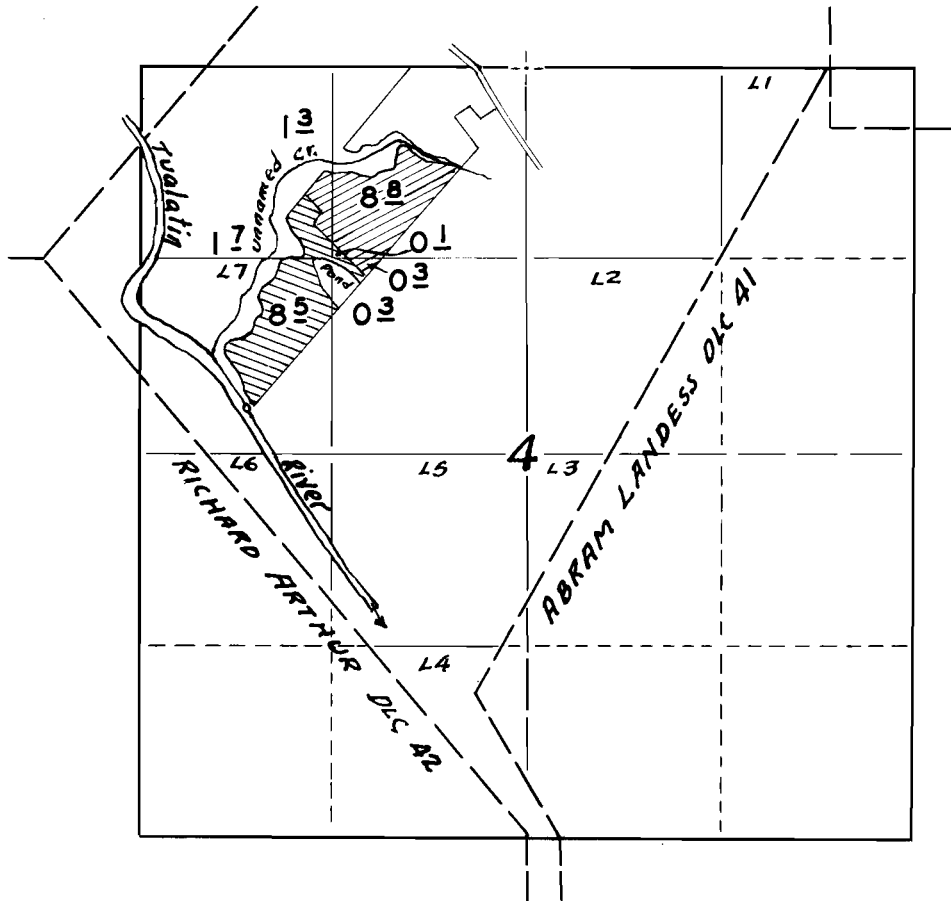

PRIMARY
SUPPLEMENTAL

FINAL PROOF SURVEY

UNDER

Application No. 17741 Permit No. 13436
IN NAME OF

VICTOR D. FOSTER, ESTATE

Surveyed 4 - 27 1956, by M. BISH