


T. 8 S. R. 3 W. W.M.

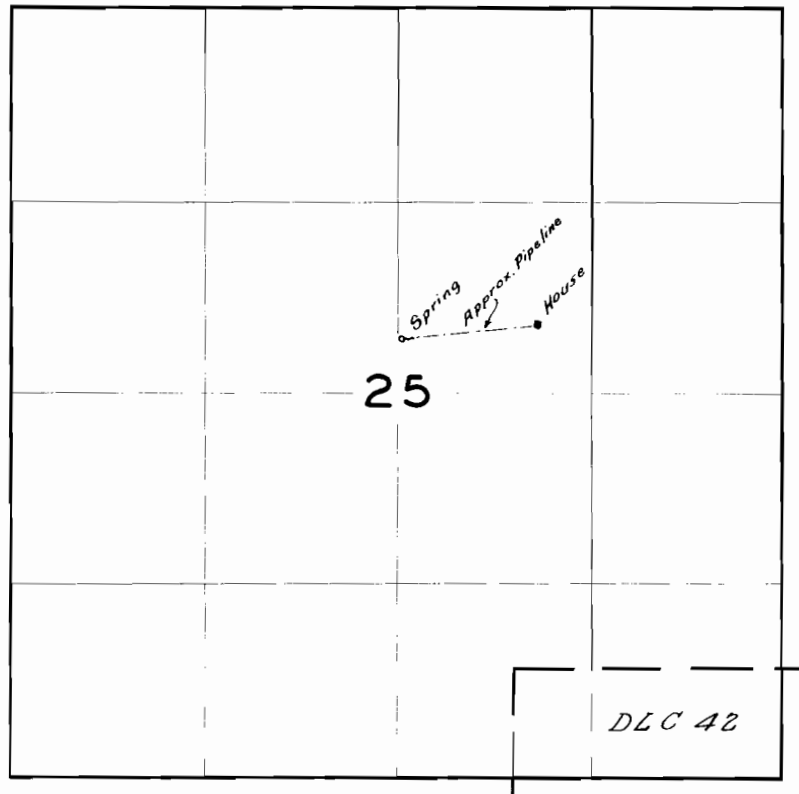

FINAL PROOF SURVEY
UNDER

Application No. 18966... Permit No. 14565...
IN NAME OF

Joseph L Perkins

Surveyed June 4, 1956, by R.H. Whitby...