


T. 2 S., R. 2 W., W.M.

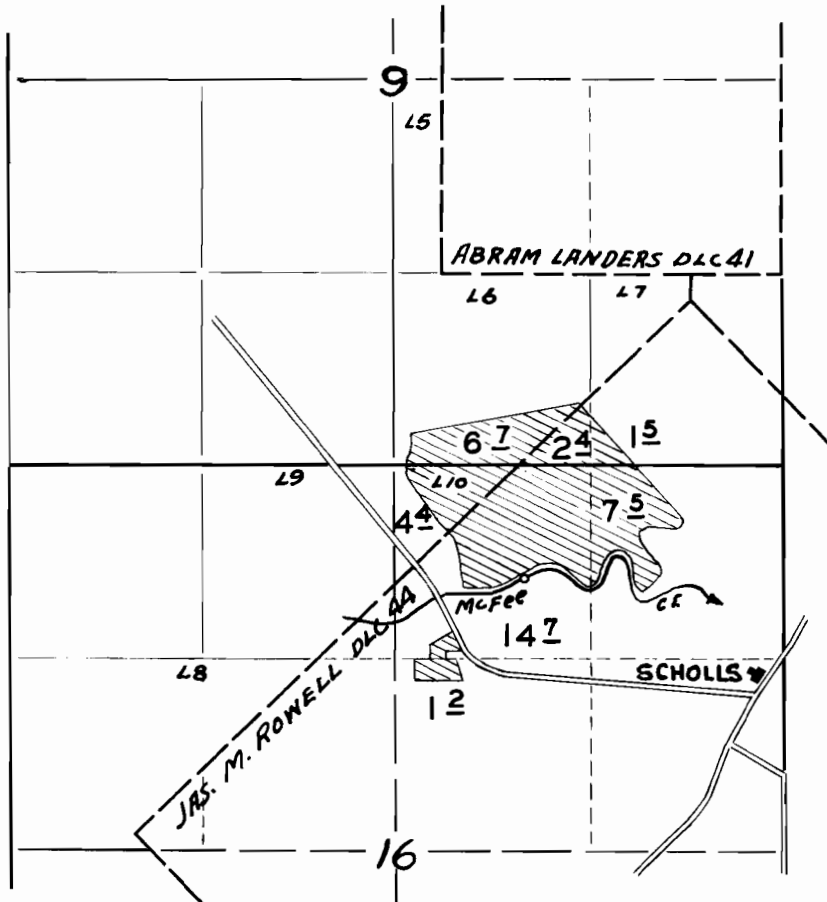

FINAL PROOF SURVEY
UNDER

Application No. 19658 Permit No. 15240
IN NAME OF

Wm. B. Dixon

Surveyed 5 - 2 1956 by M. BISH