


T. 2 S., R. 2 W., W.M.

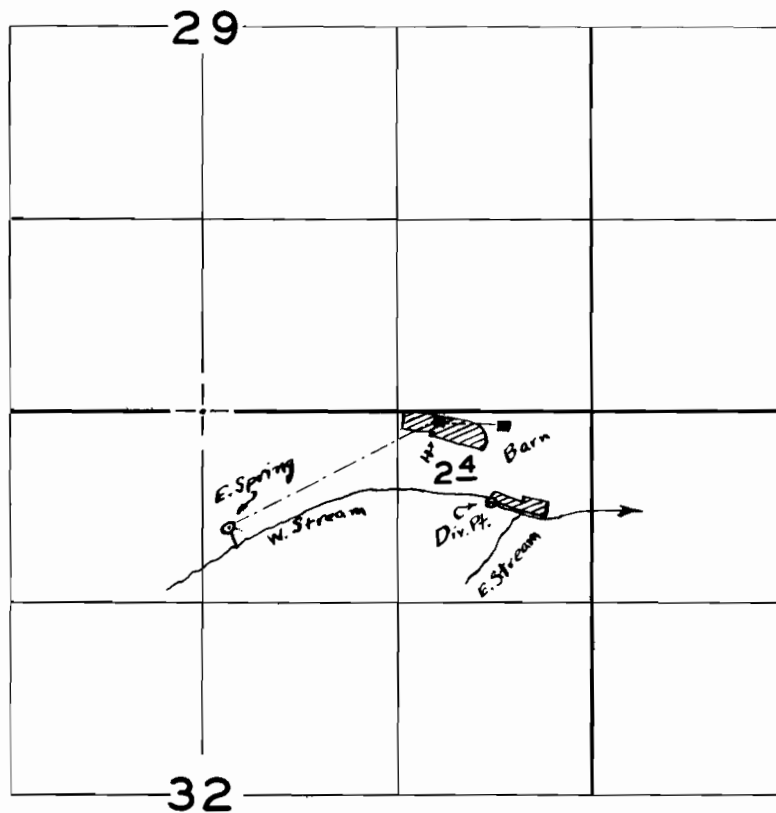

FINAL PROOF SURVEY

UNDER

Application No. 20028 Permit No. 15599

IN NAME OF

W. H. GALINAT

Surveyed 5 - 1 1956 by M. BISH