



,


[illegible]

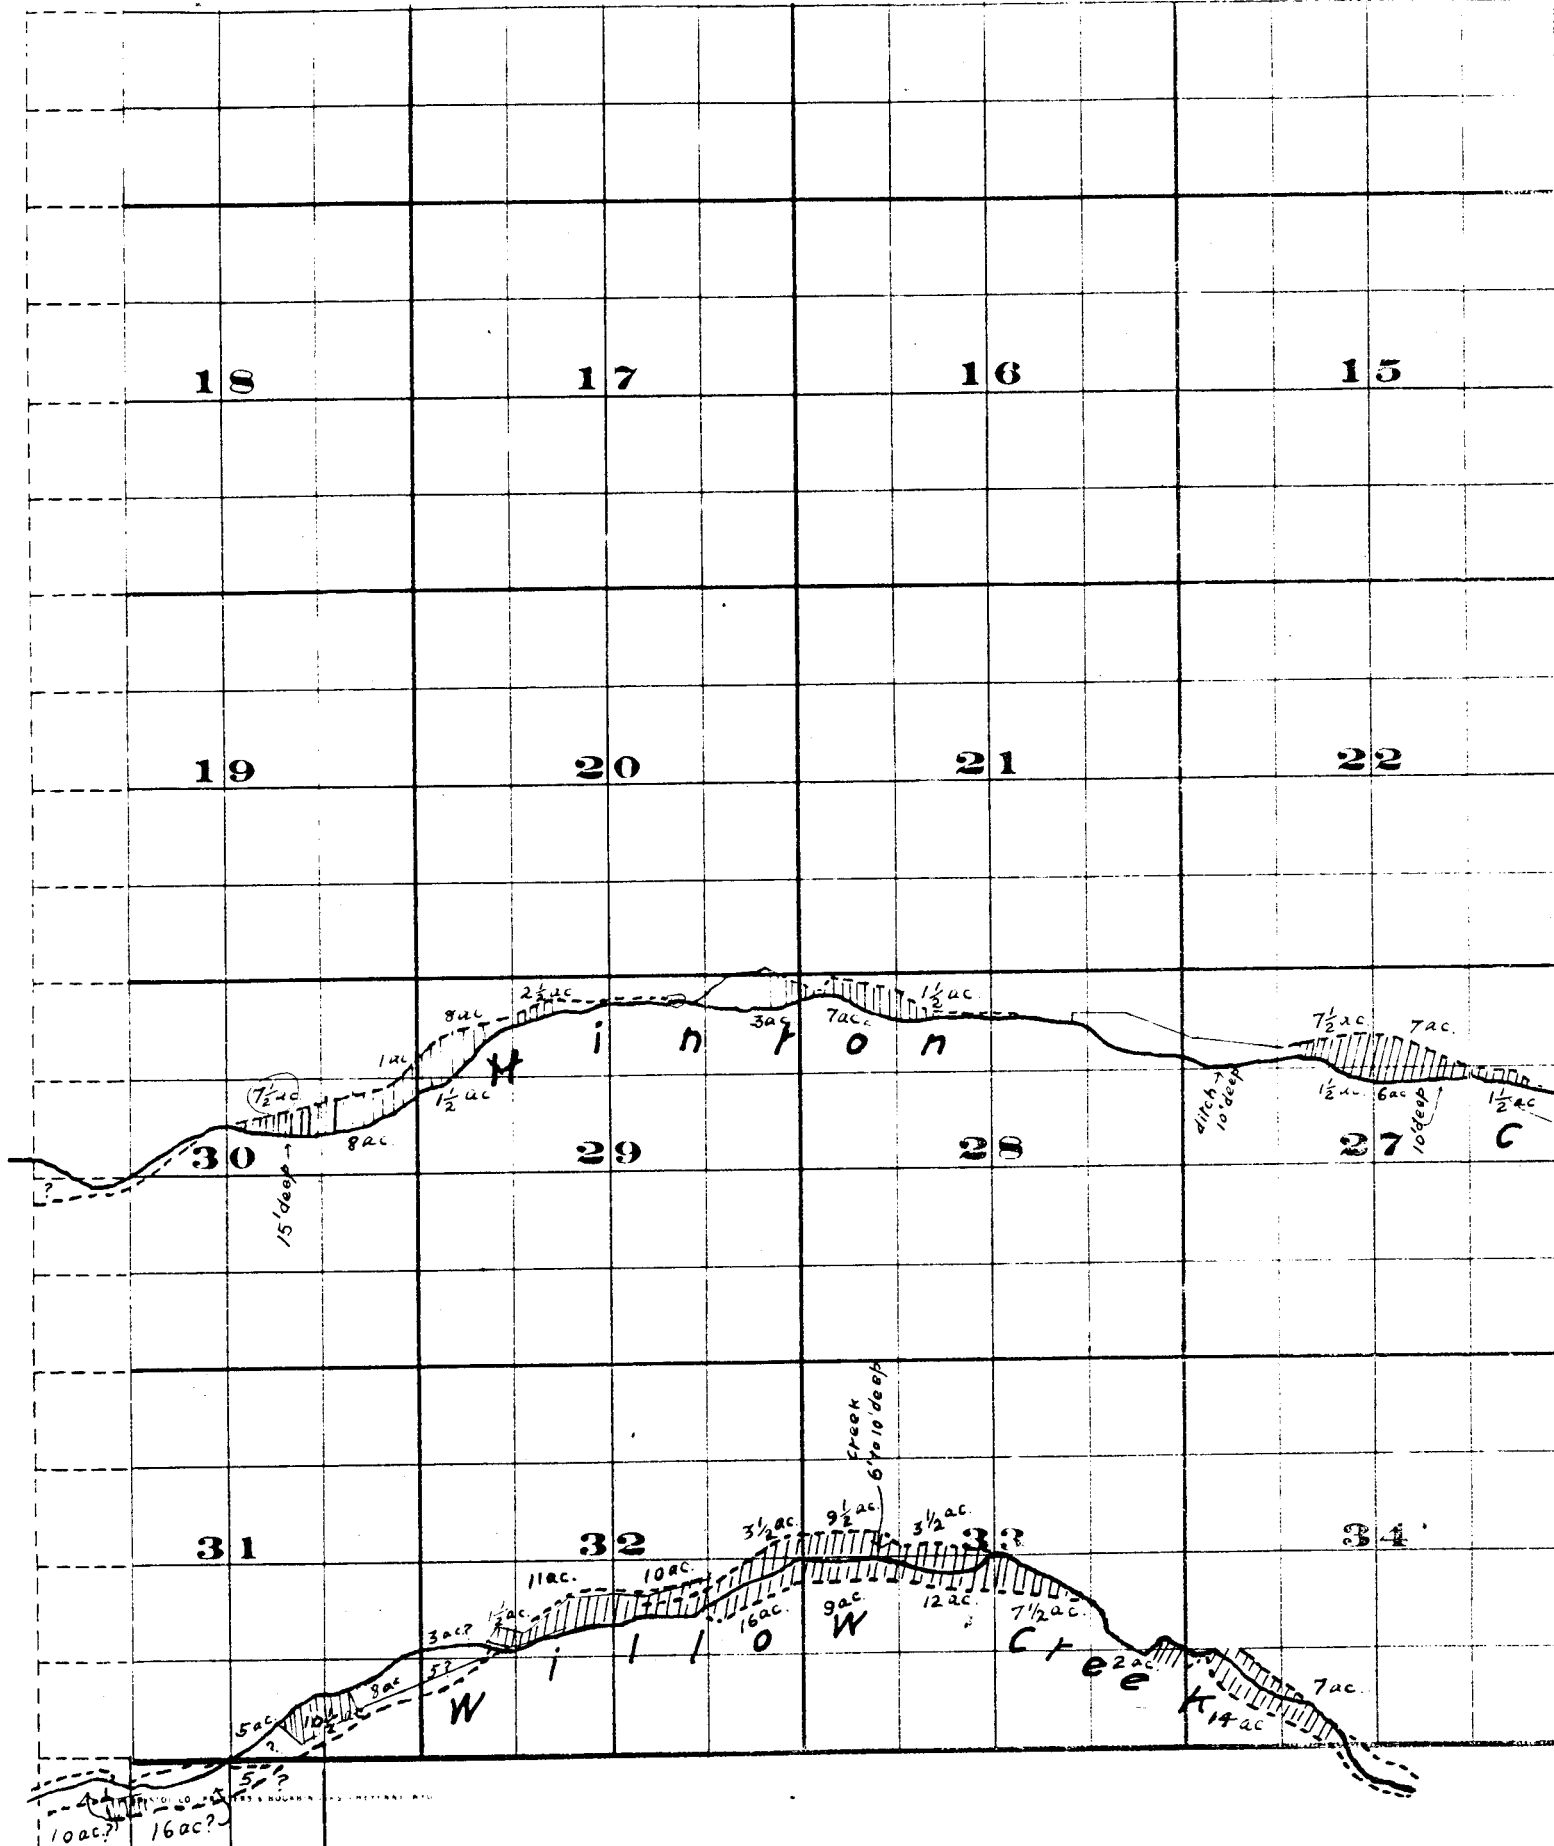

Surveyed by H. K. Donnelly & D. D. Cooper July
 John H. Lewis - State Engineer
 Examined July 14, 1909.

Township 2 S.

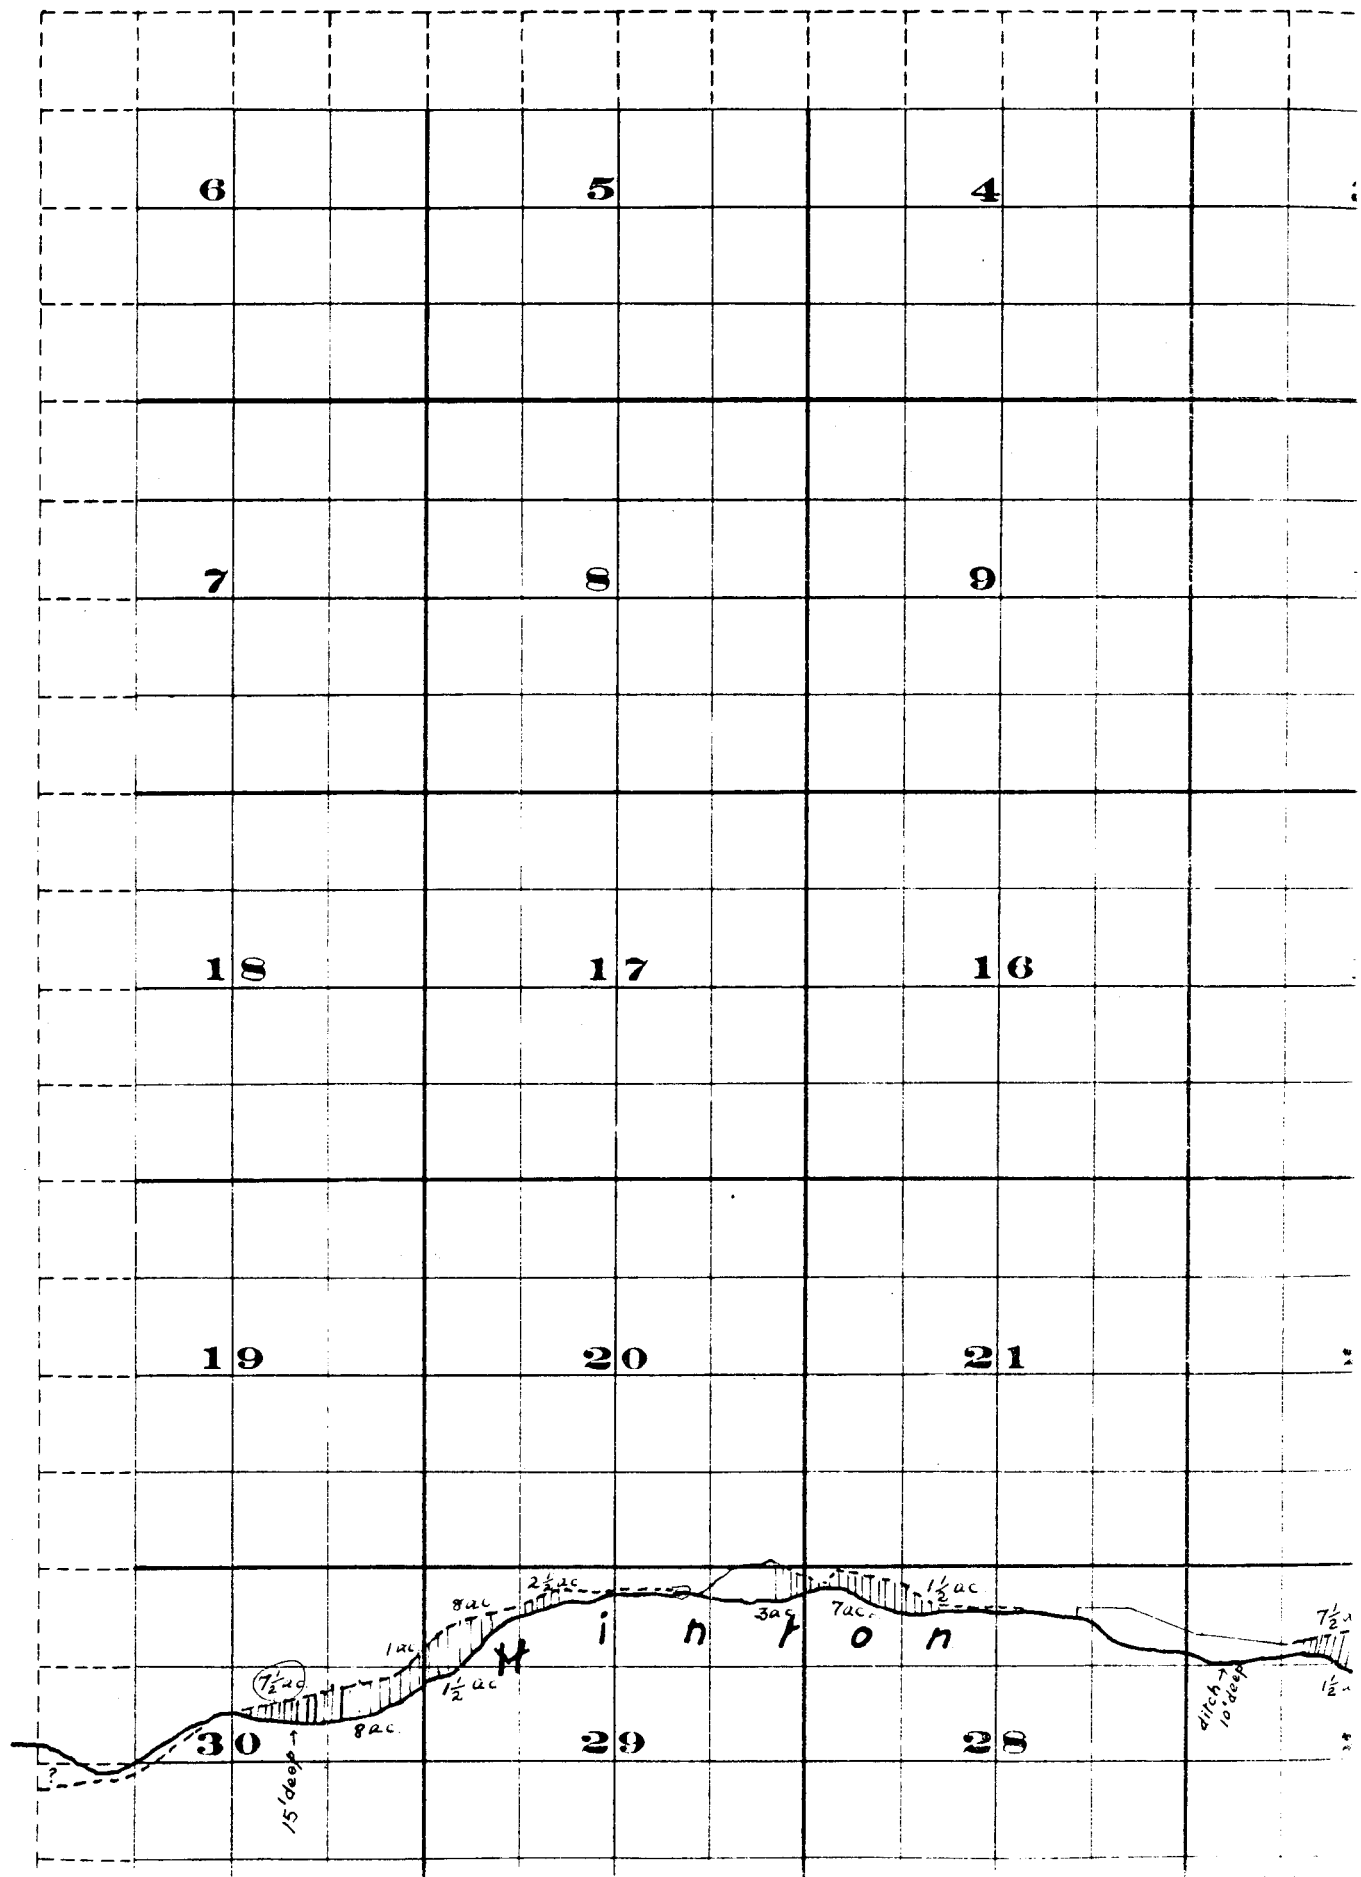

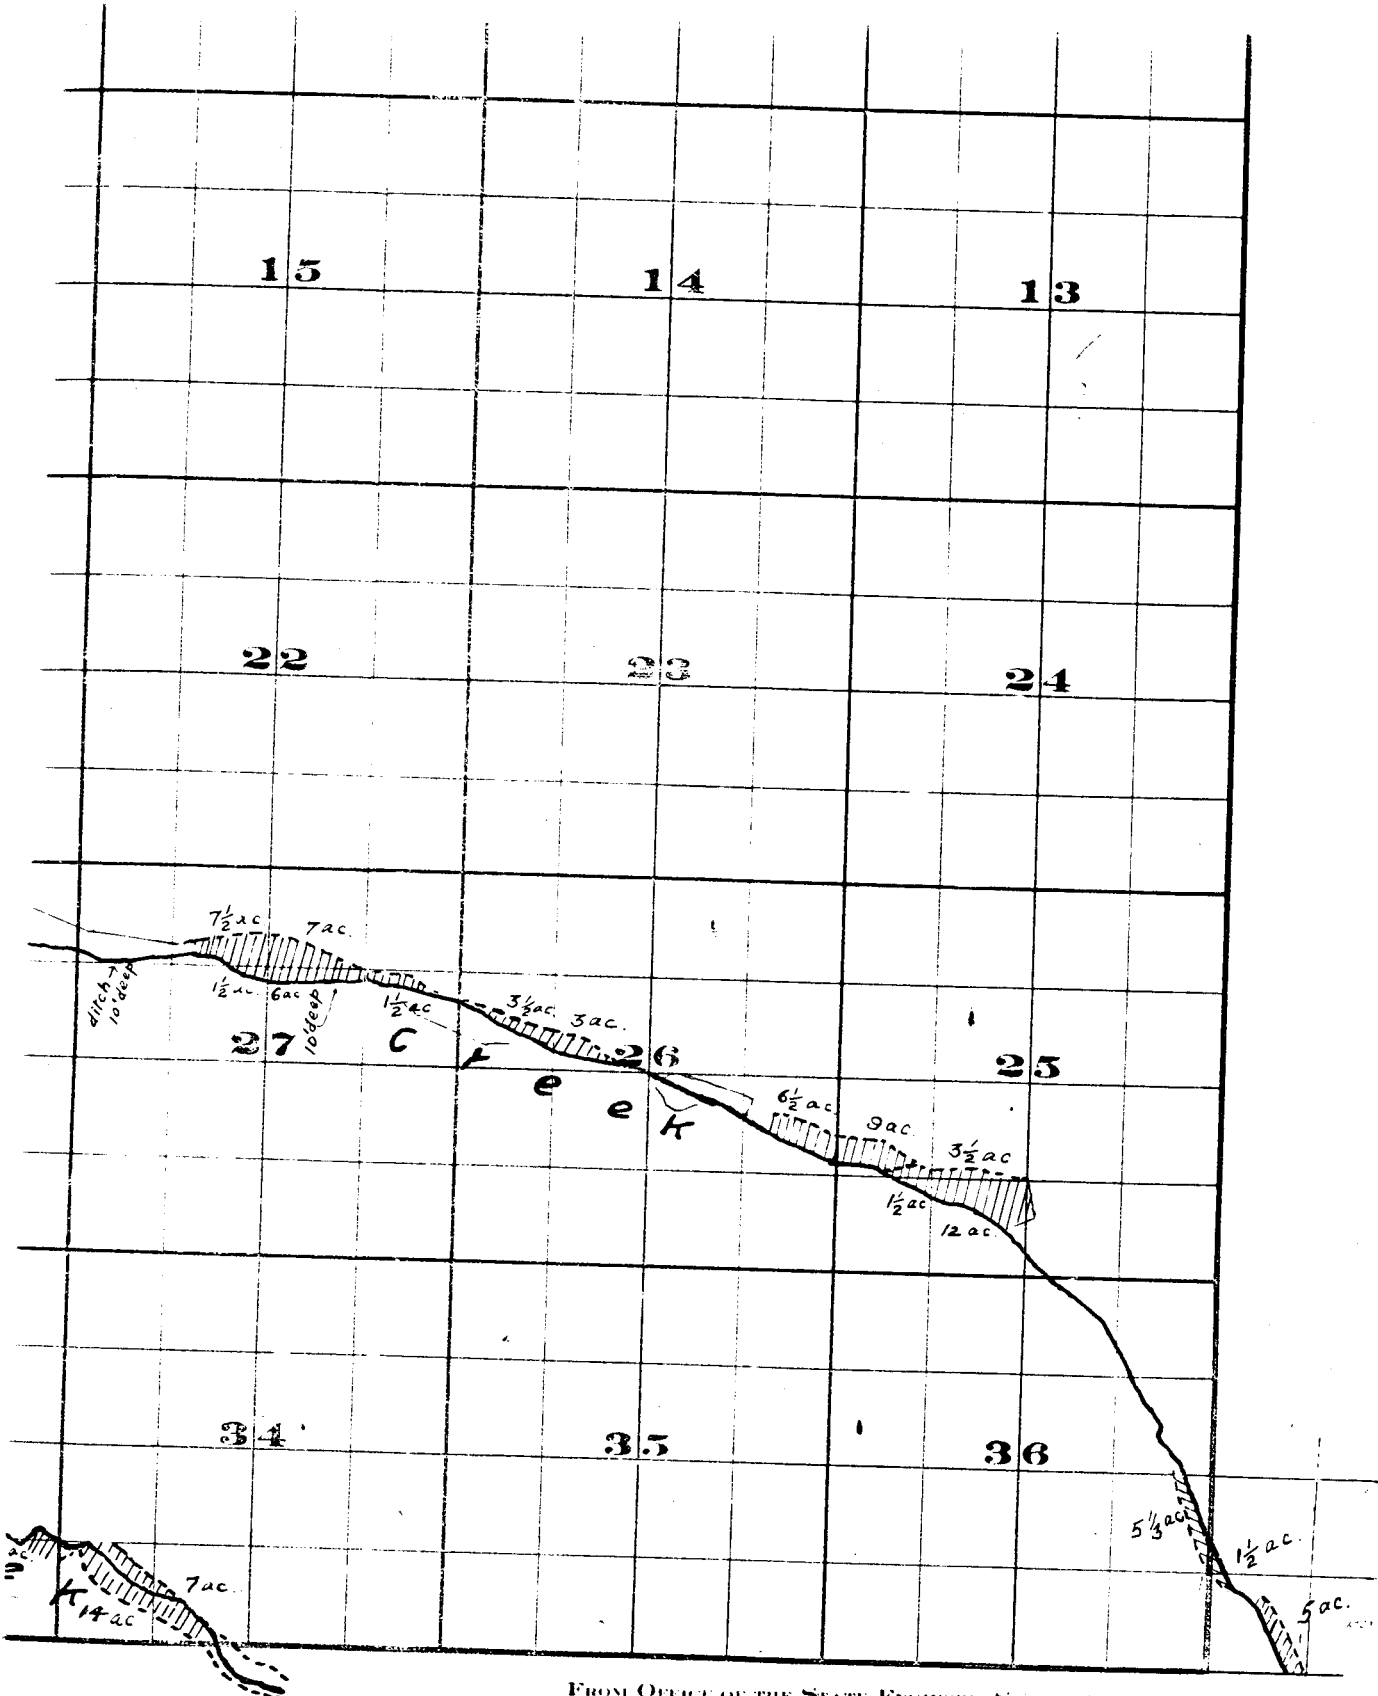

FROM OFFICE OF THE STATE ENGINEER, SALEM, OREGON

per July 1909
the Engineer

Willow Creek Adjudication

2 S. 27 E

Part 2 S. 28 E


Part 3 S. 27 E

15			14			13			
22			23			24			
27			26			25			
34			35			36			

FROM OFFICE OF THE STATE ENGINEER, SALEM, OREGON

Willow Creek Adjudication.


35.28 E.

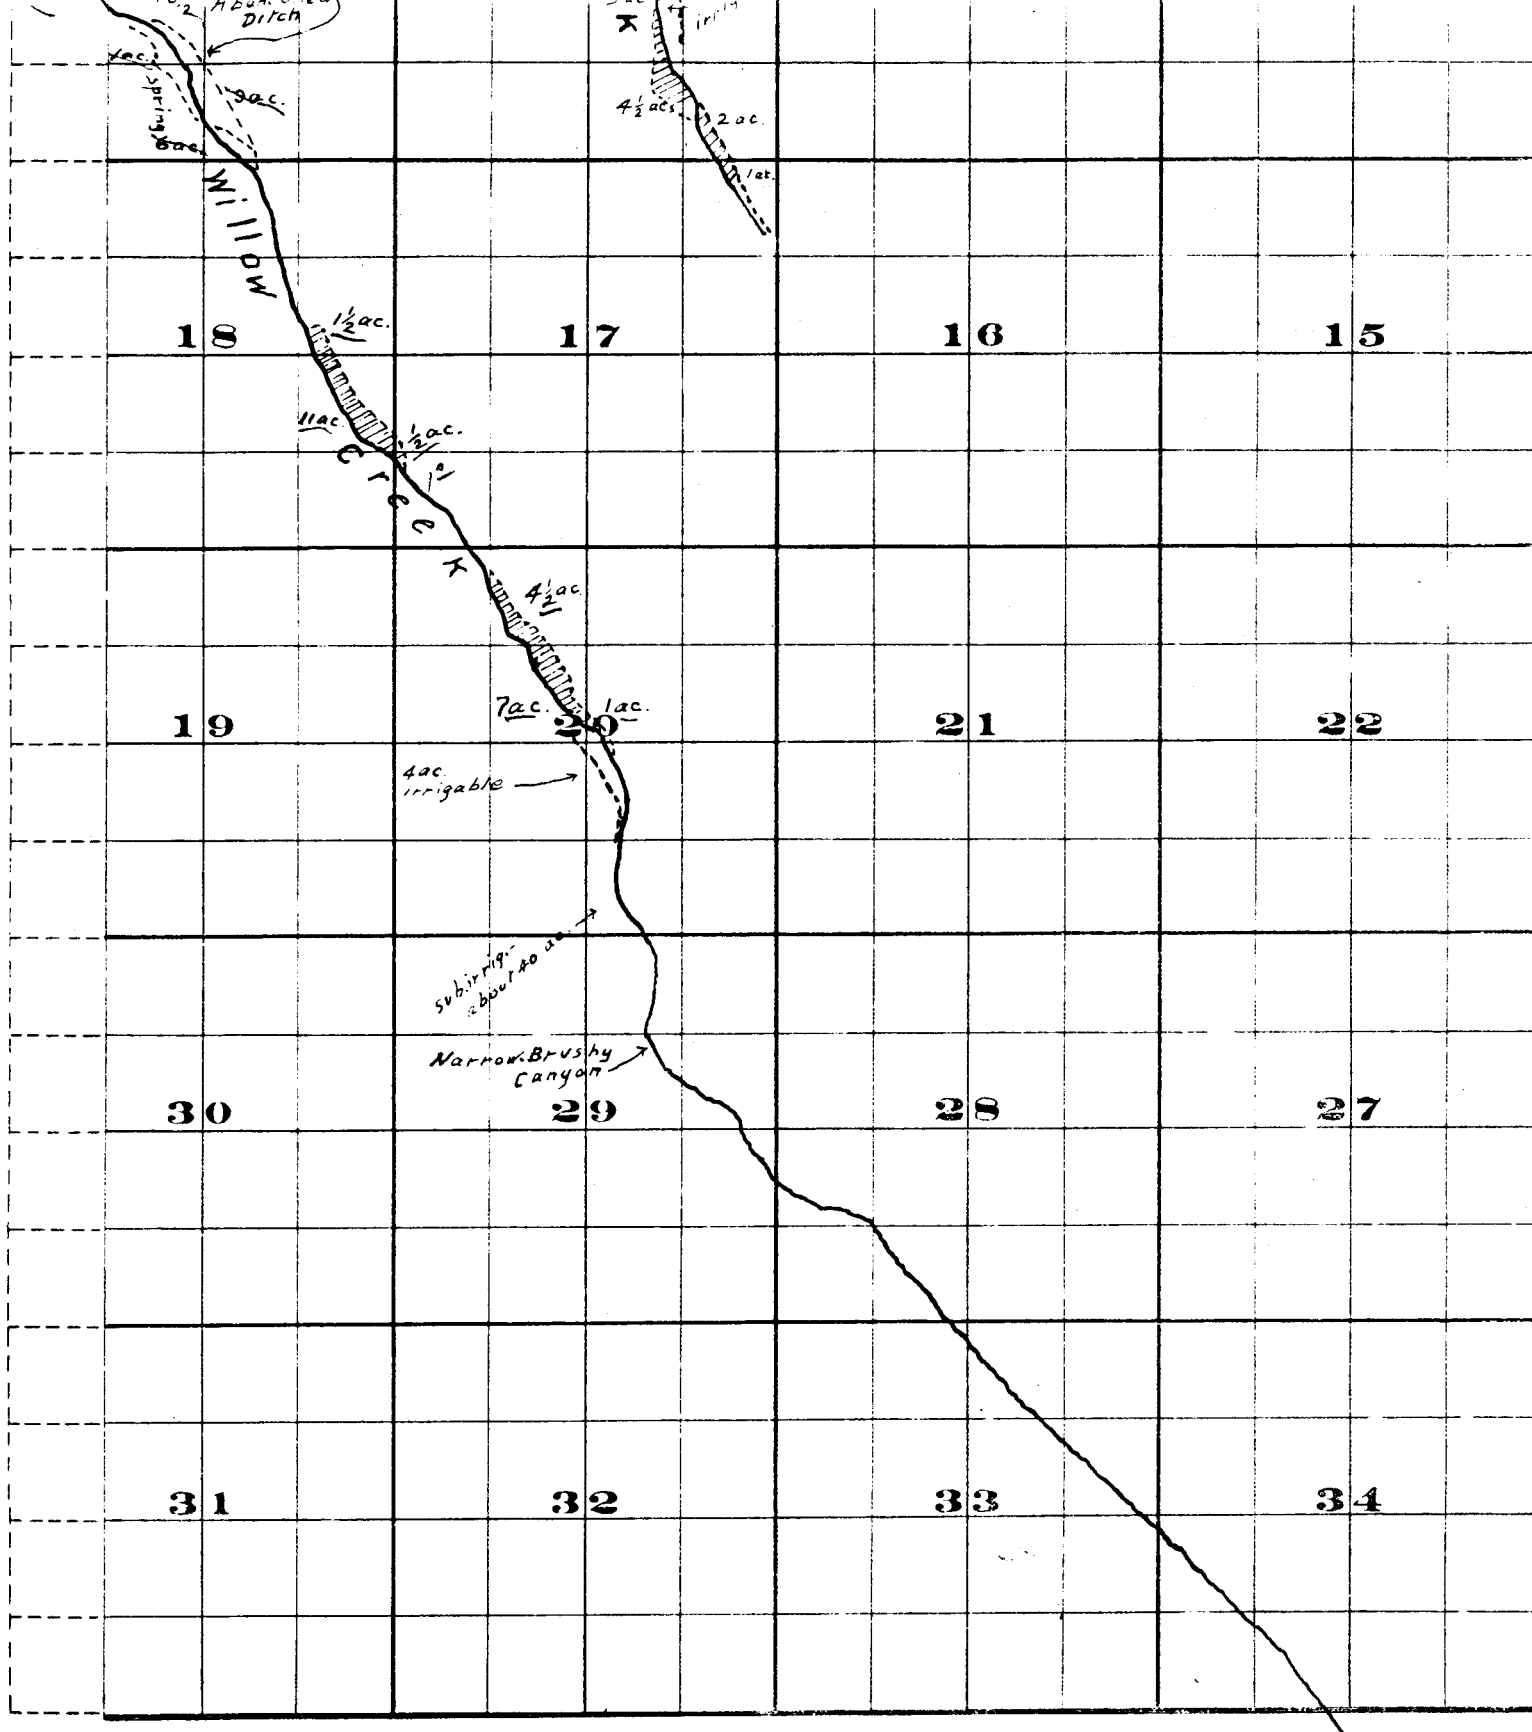


Hinton Creek Surveyed by H.K. Donnelly July 1909
 Willow Creek Surveyed by R.D. Cooper July 1909
 John H. Lewis - State Eng'r.
 Examined July 14, 1909.

Township 3. S.

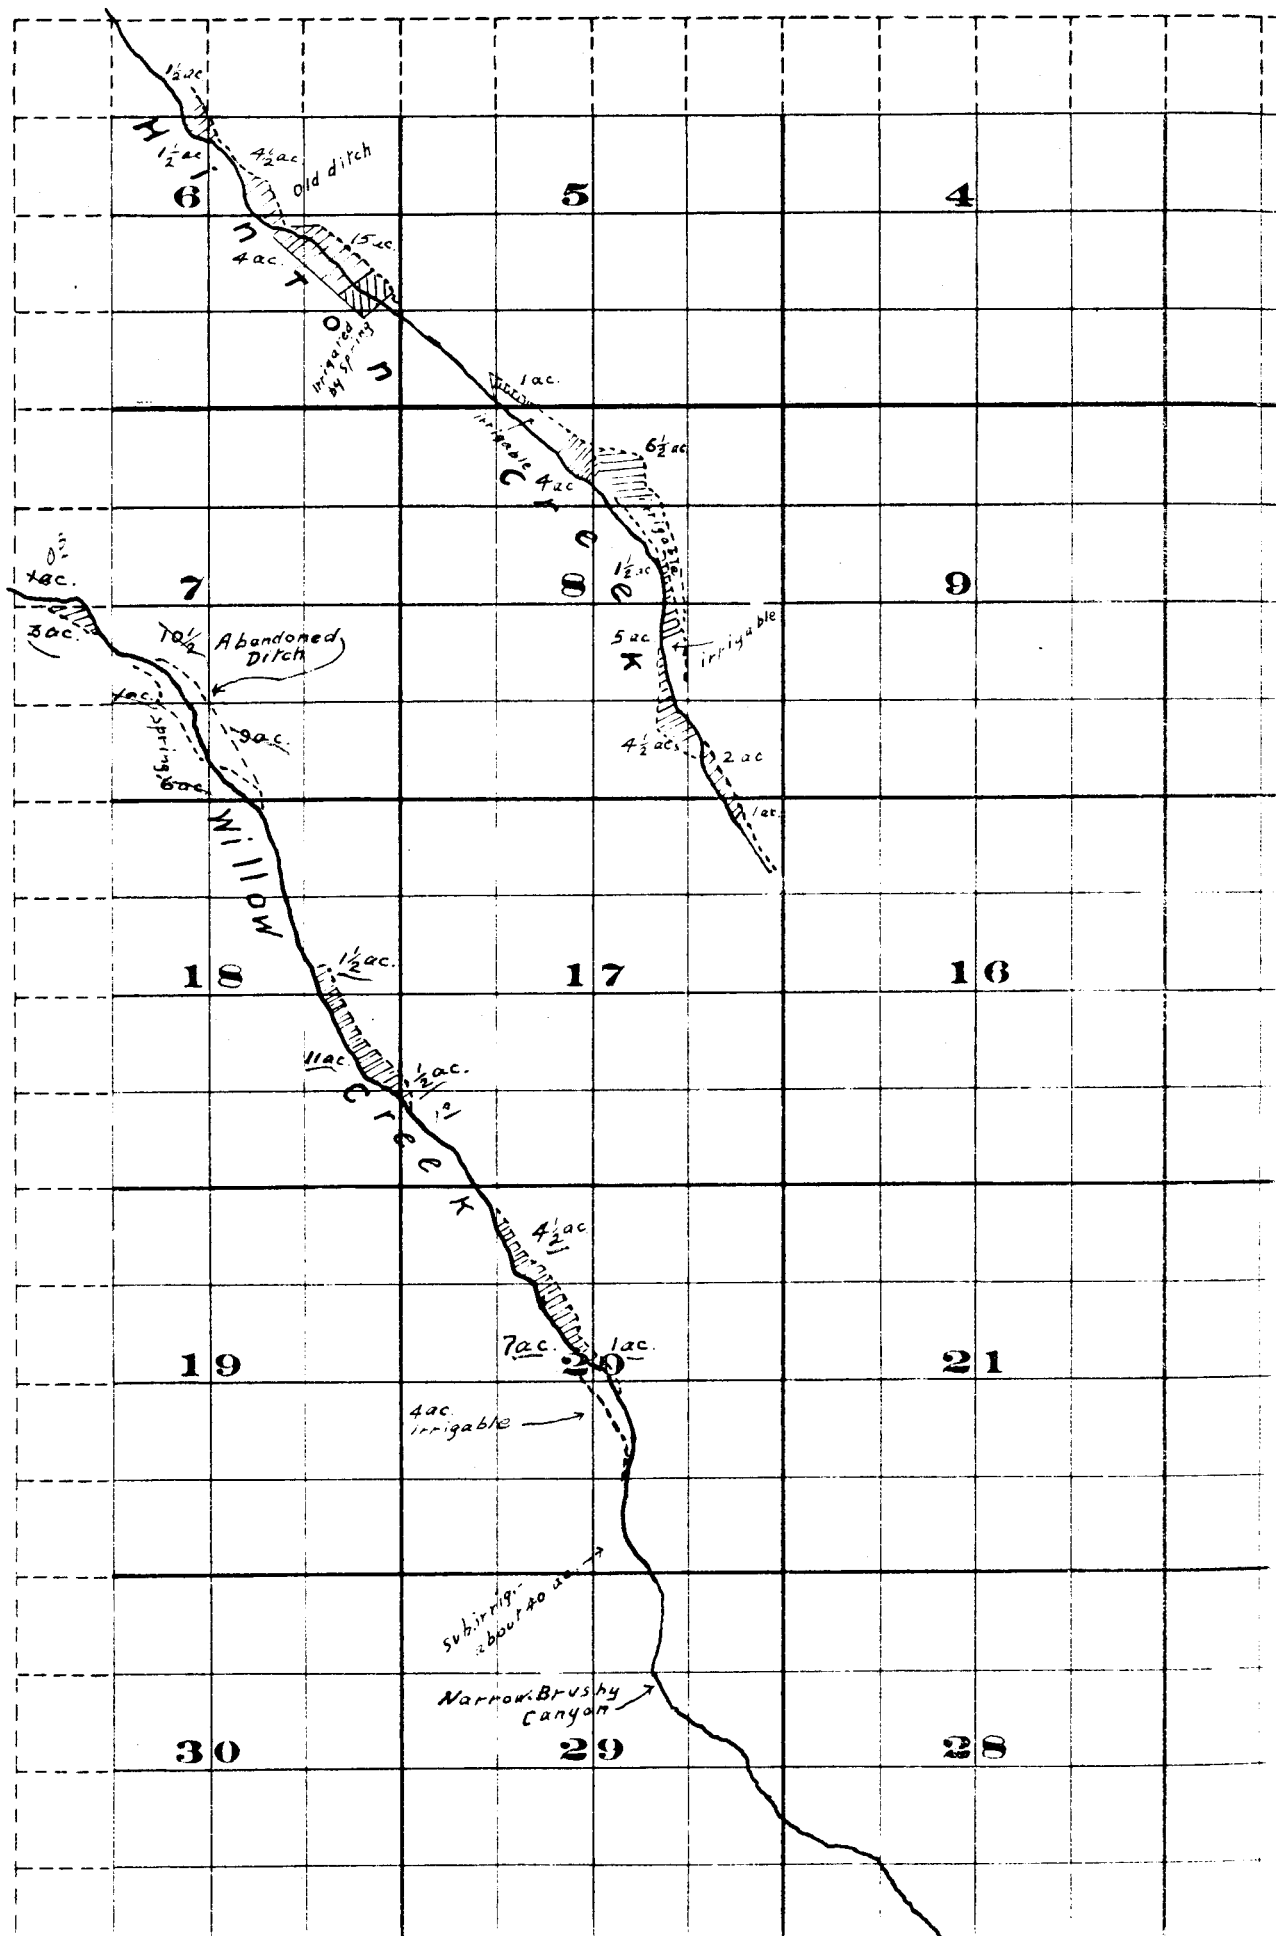

[illegible]