T. 4S. R. 1&2W. W.M.

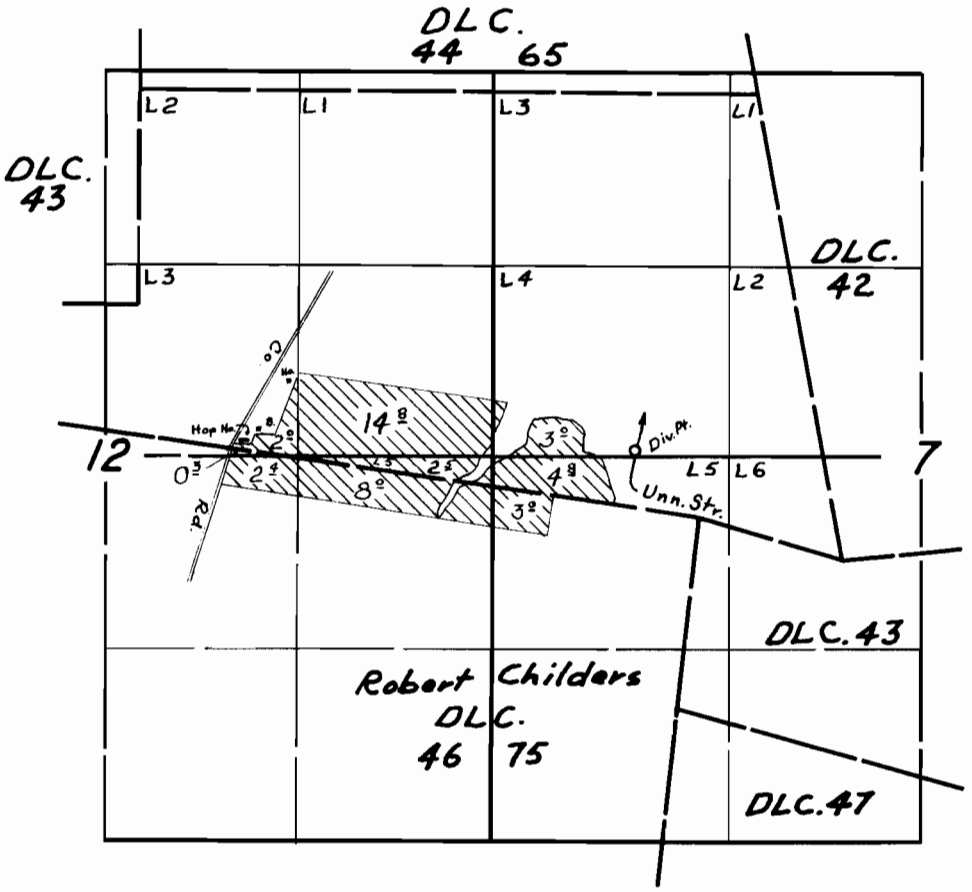

FINAL PROOF SURVEY

UNDER

Application No. 20462 Permit No. 16067

IN NAME OF

KIRSCH BROTHERS

Surveyed 26 Sept. 1956, by M. Bish

DFN-2D-96