


# T. I. S. R. I. W. W. M.

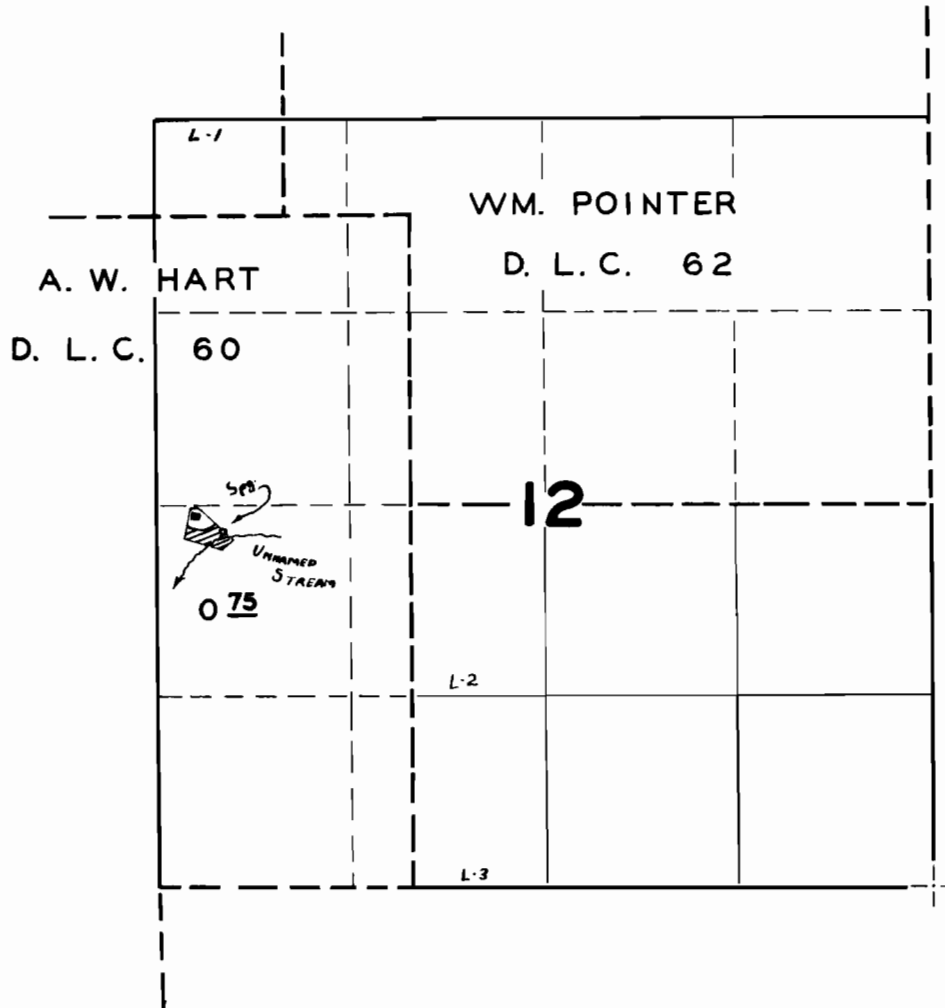

## FINAL PROOF SURVEY UNDER

Application No. 20545 Permit No. 16039  
IN NAME OF

H. KILDOW

Surveyed JUNE 26 1951, by H. L. COFFMAN