T. 7 S. R. 45 E. W. M.

FINAL PROOF SURVEY

UNDER

Application No. 20902 Permit No. 16369

IN NAME OF

Francis L. Motley
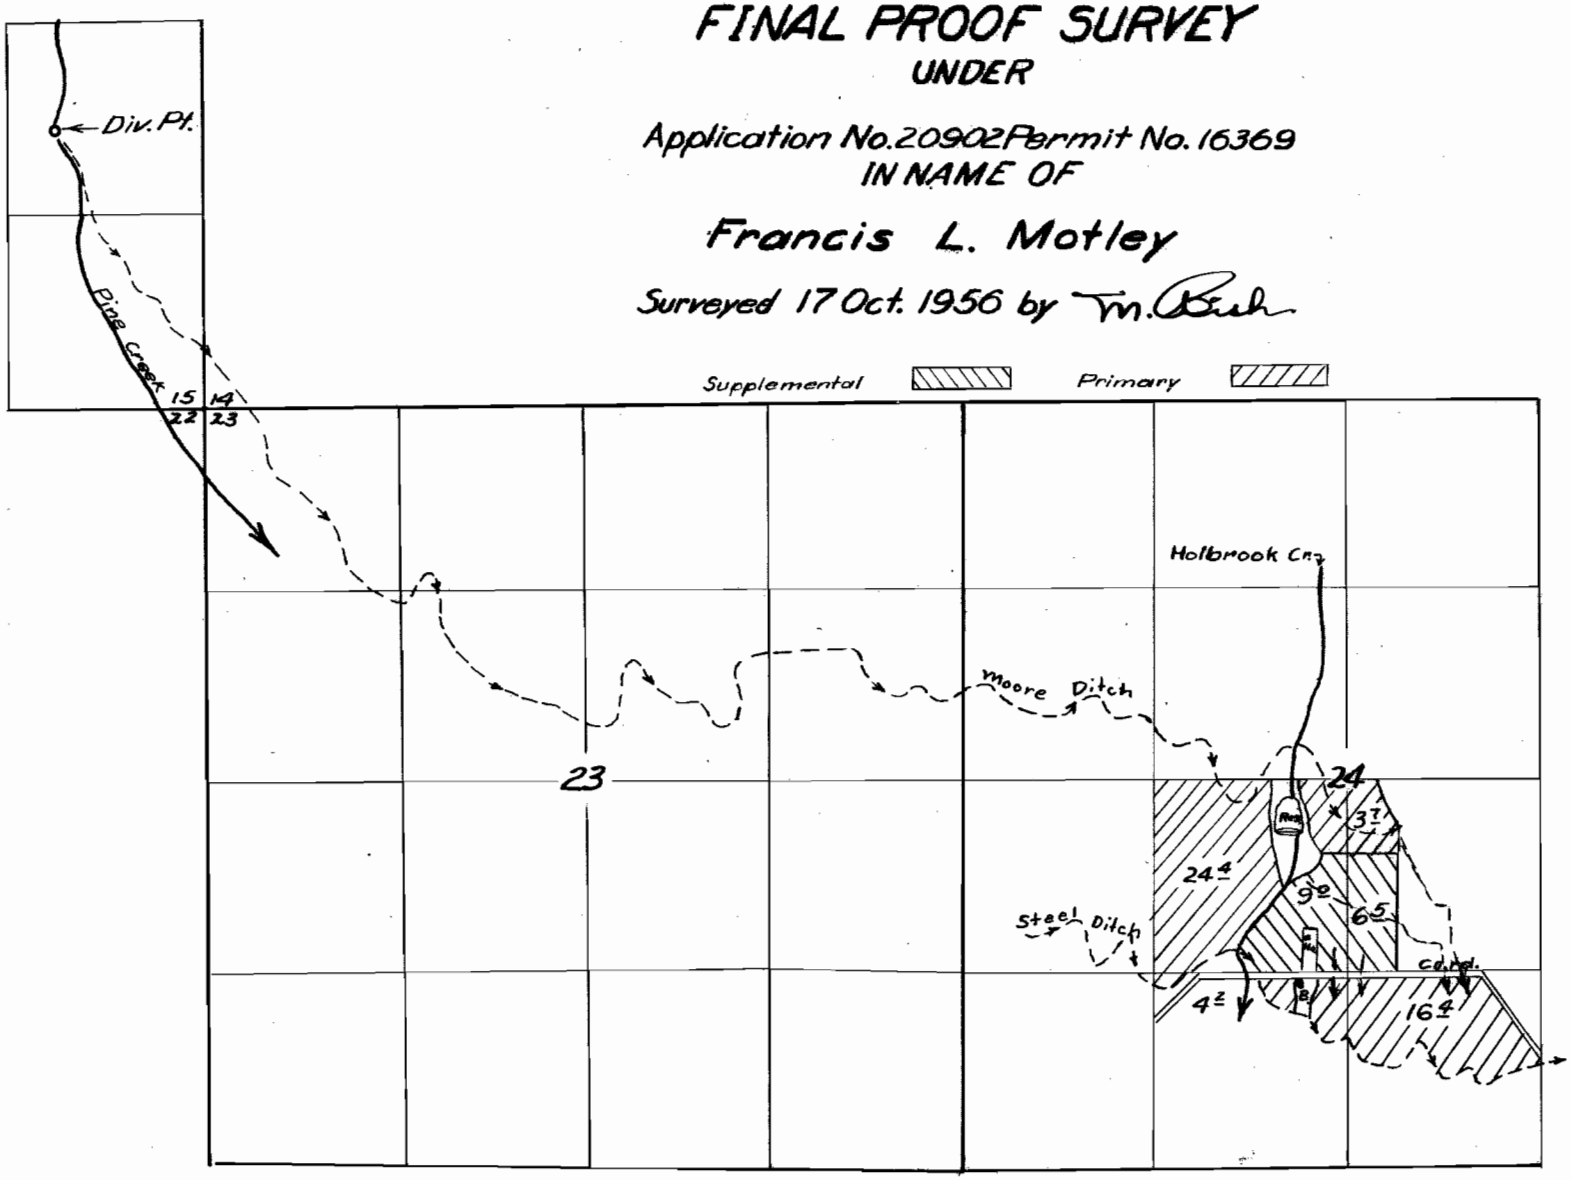
Surveyed 17 Oct. 1956 by Tm. Bush