


T. 2S. R. 2E. W.M.

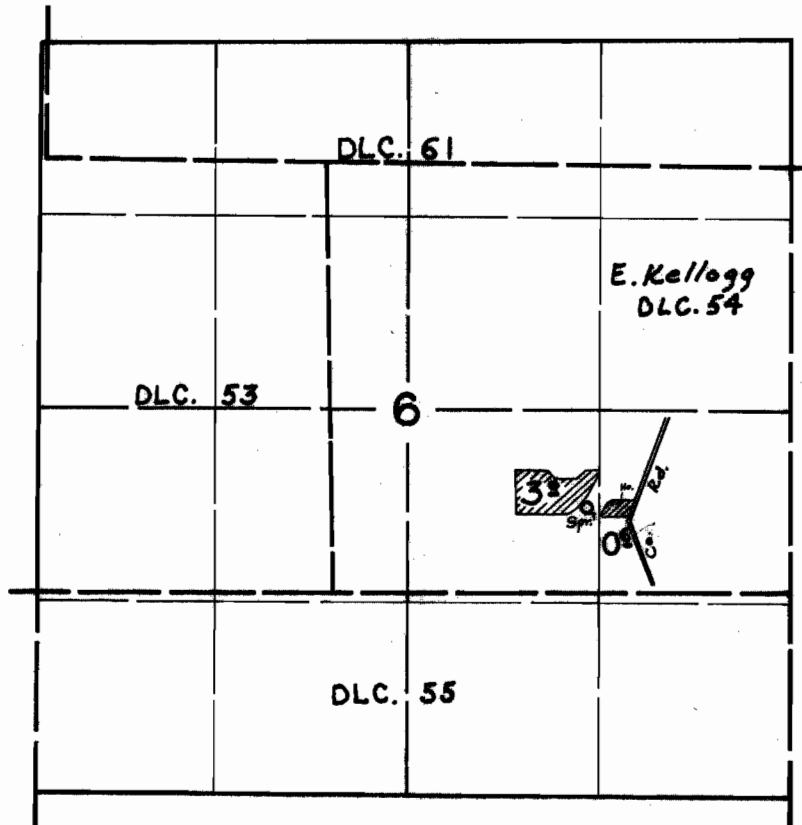

**FINAL PROOF SURVEY**

UNDER

Application No. 21060 Permit No. 16603

IN NAME OF

GEORGE F. & ALICE SCHIEWE

Surveyed 17 May 1956, by M. Bish

2/25