


T.2S., R.1E., W.M.

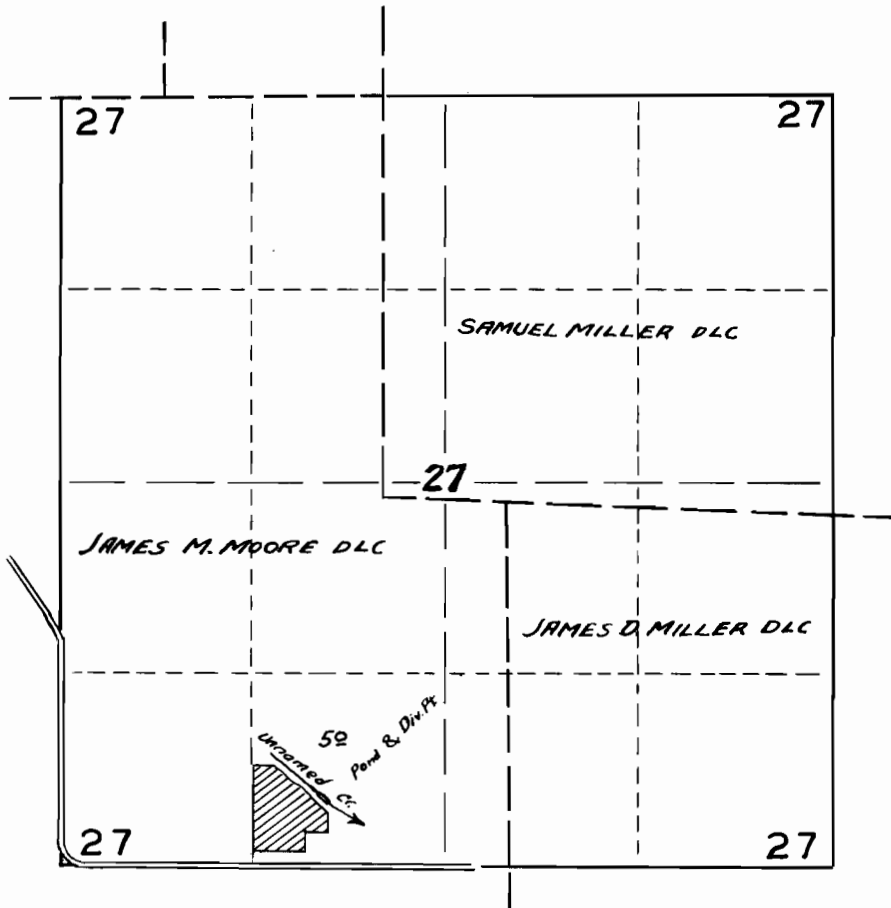

FINAL PROOF SURVEY

UNDER

Application No. 21106 Permit No. 16539

IN NAME OF

CLARKE HUGHES

Surveyed 5-14 1956, by R.D.BEST