


T. 26 S., R. 3 W., W. M.

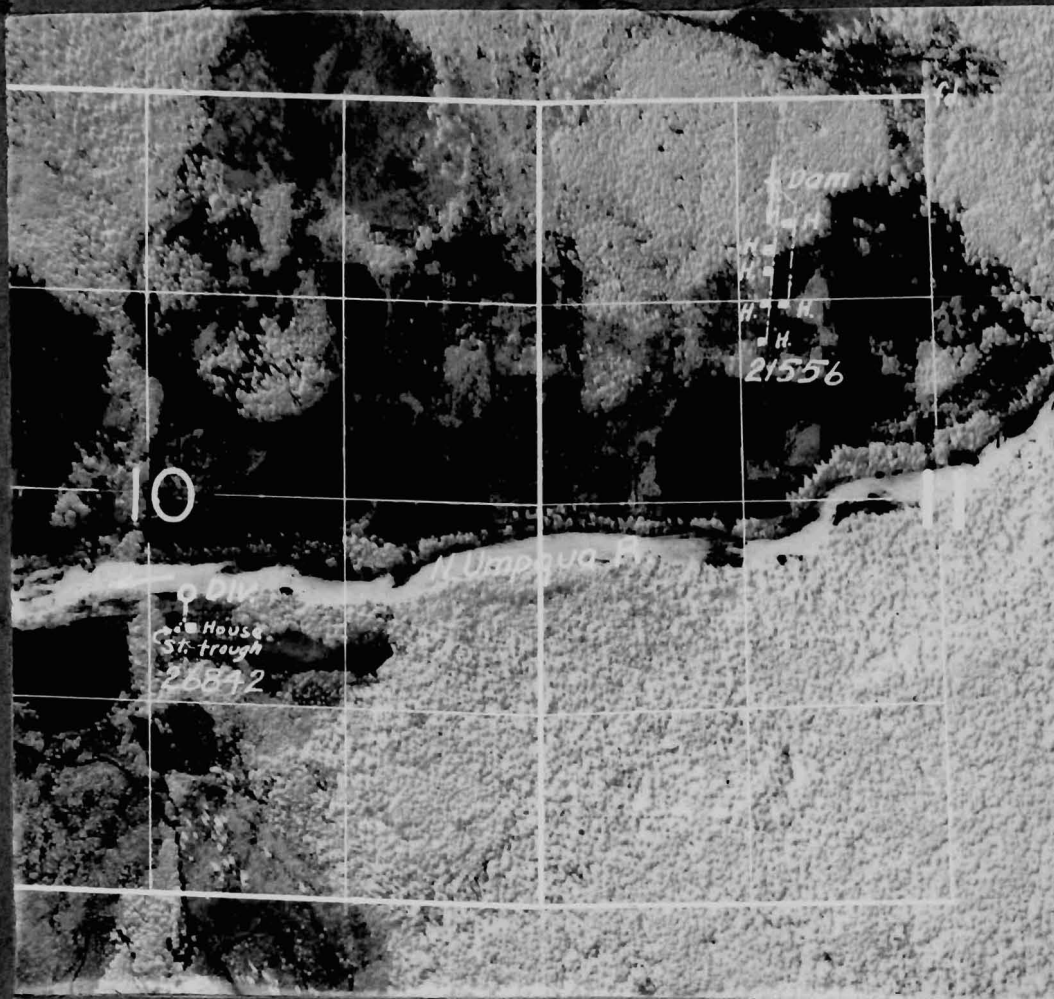

FINAL PROOF SURVEY

UNDER

Application No. ²¹⁵⁵⁶ ~~26842~~ Permit No. ¹⁶⁹⁴² ~~21081~~

IN NAME OF

BYRON K. BROWN

A. B. SMITH

Surveyed Sept. 3 1953, by H. L. Coffman

DEK 6-98