

AMITY QUADRANGLE

OREGON


7.5 MINUTE SERIES (TOPOGRAPHIC)

SW/4 McMinnville 15' QUADRANGLE


123°07'30" 45°07'30"

137° LINE DAYTON

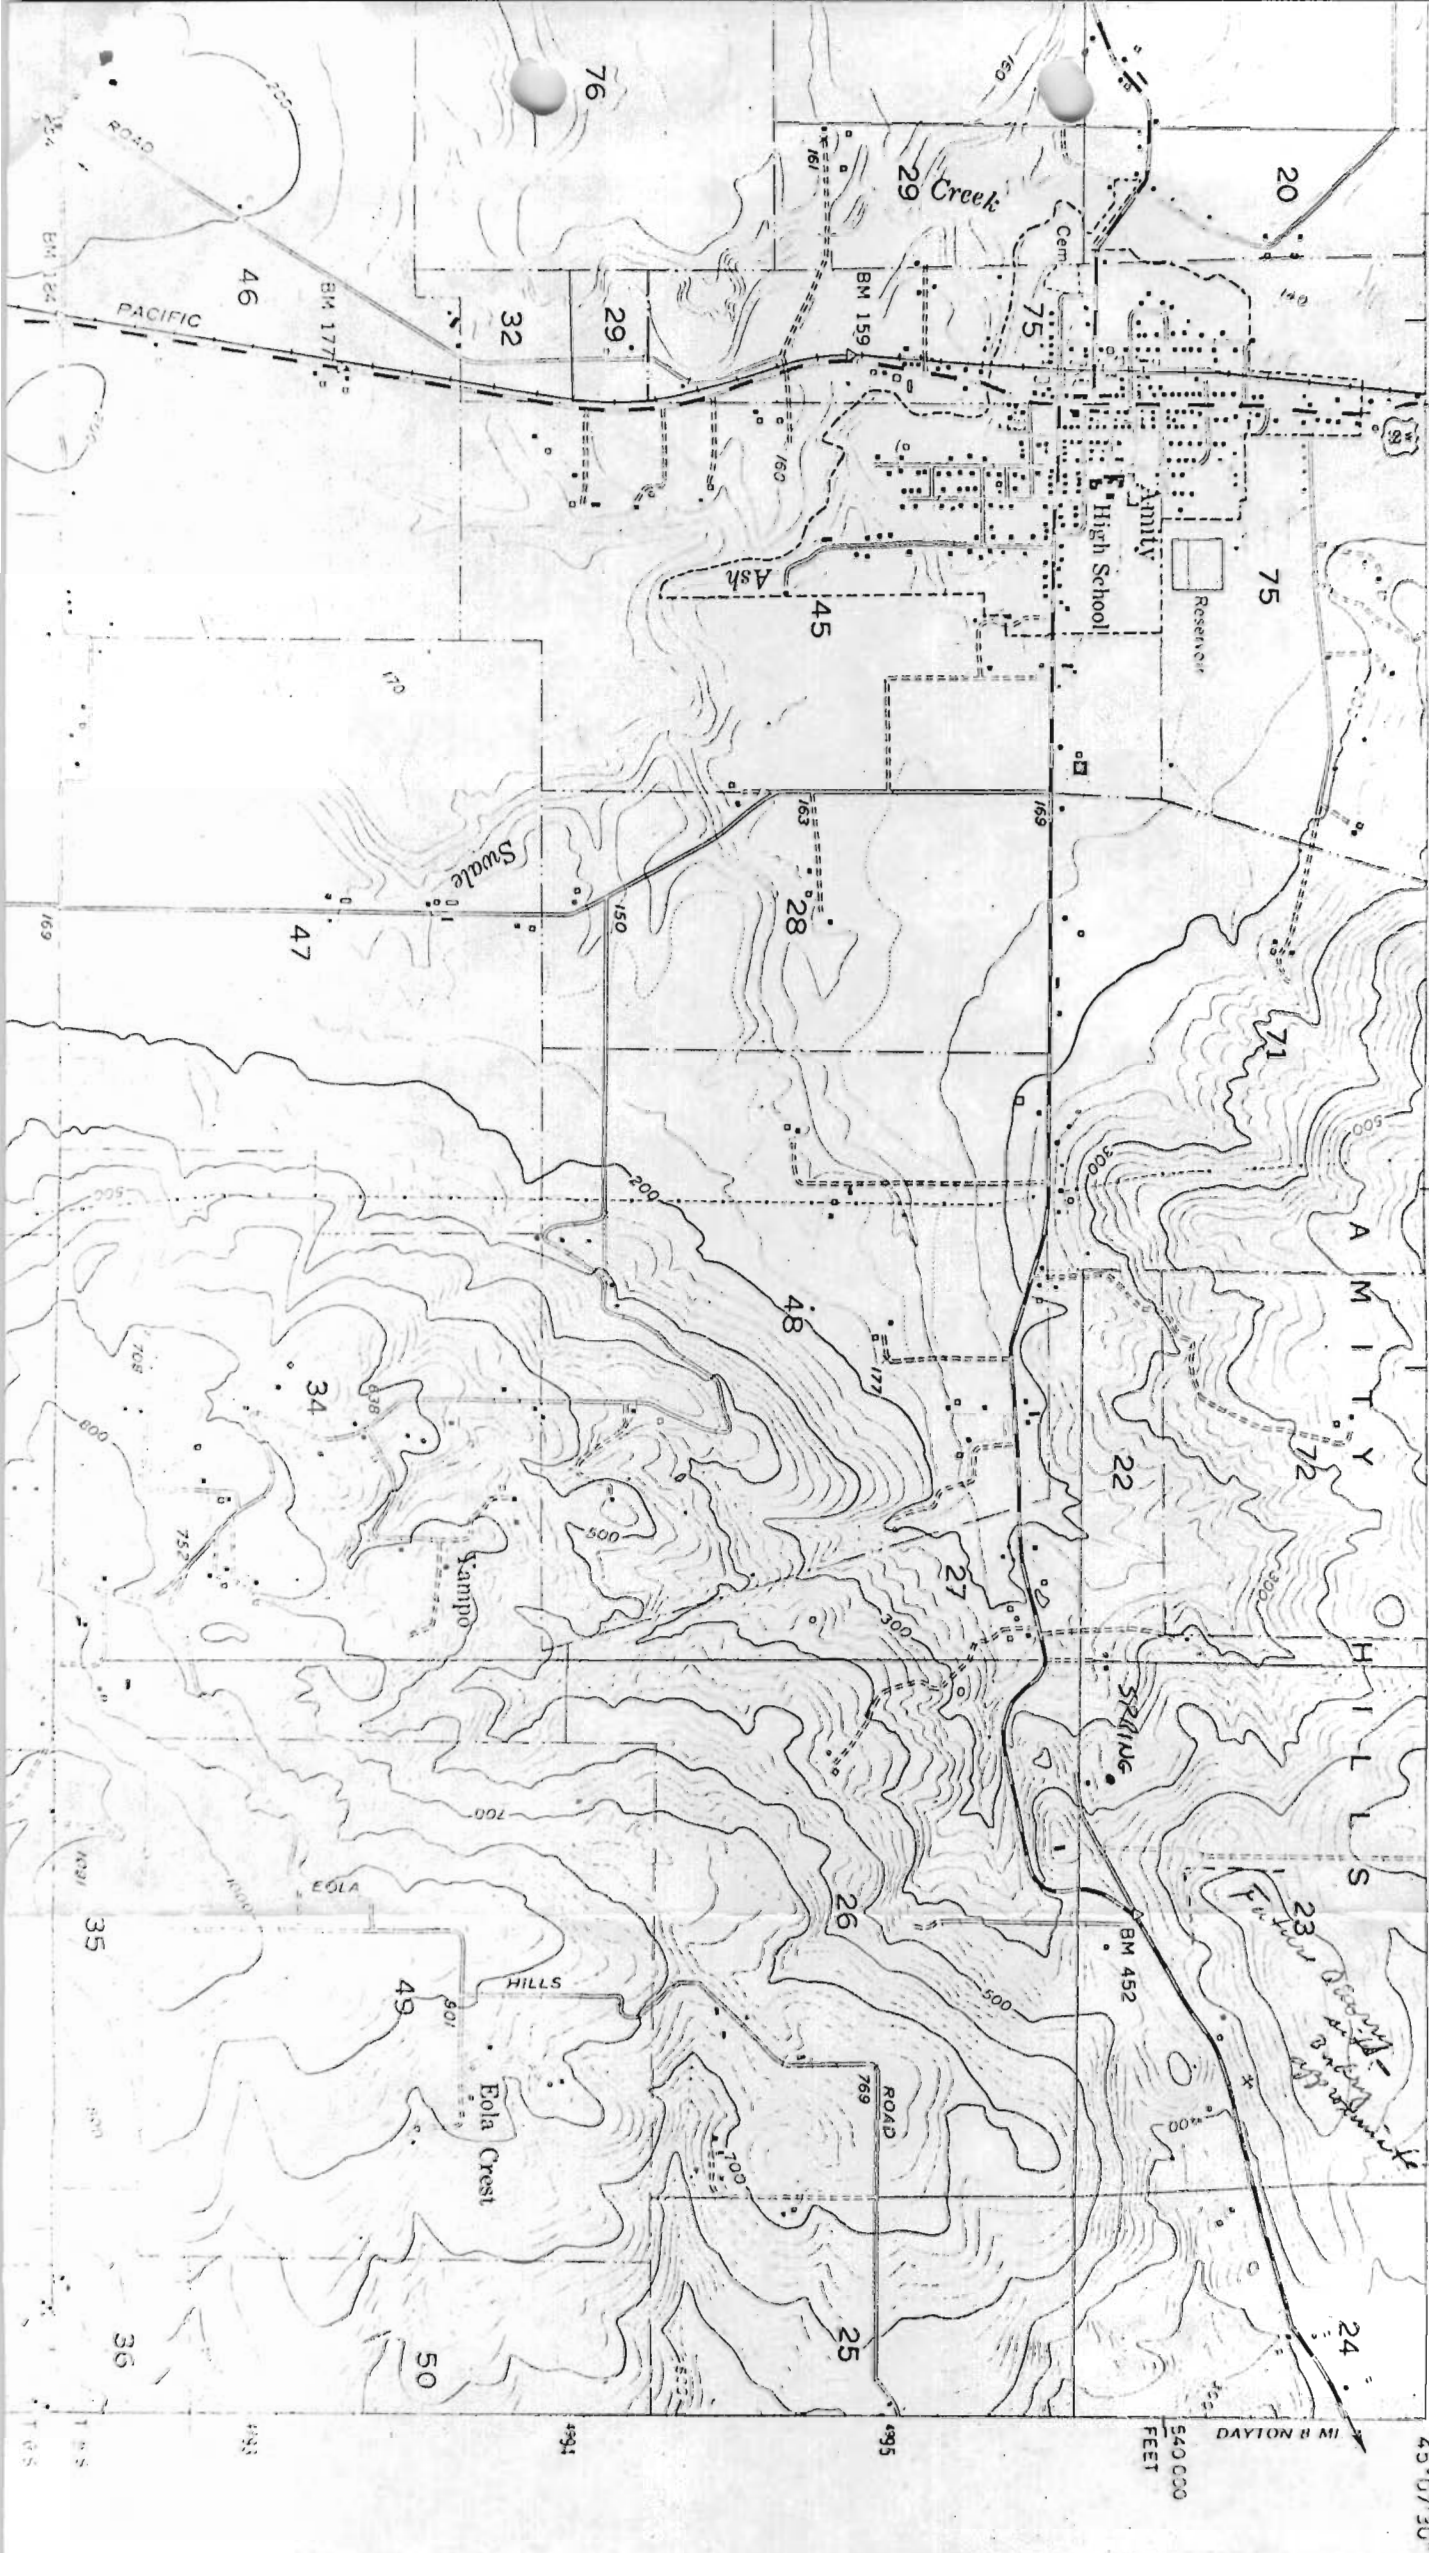

540,000 FEET