


T. 2 N., R. 4 W., W.M.

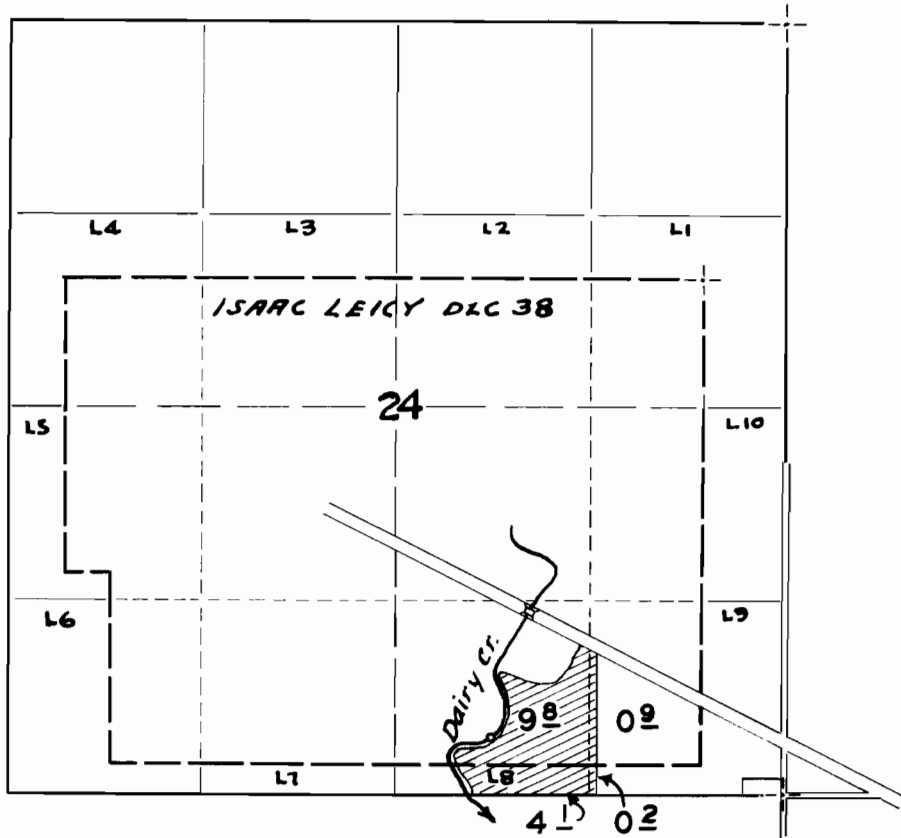

**FINAL PROOF SURVEY**

UNDER

Application No. 21717 Permit No. 17047

IN NAME OF

NORVAL E. & E. JEAN EMMETT

Surveyed 4 - 12 1956, by R.H. WHITBY