


T. 4 S. R. 3 W. W. M.

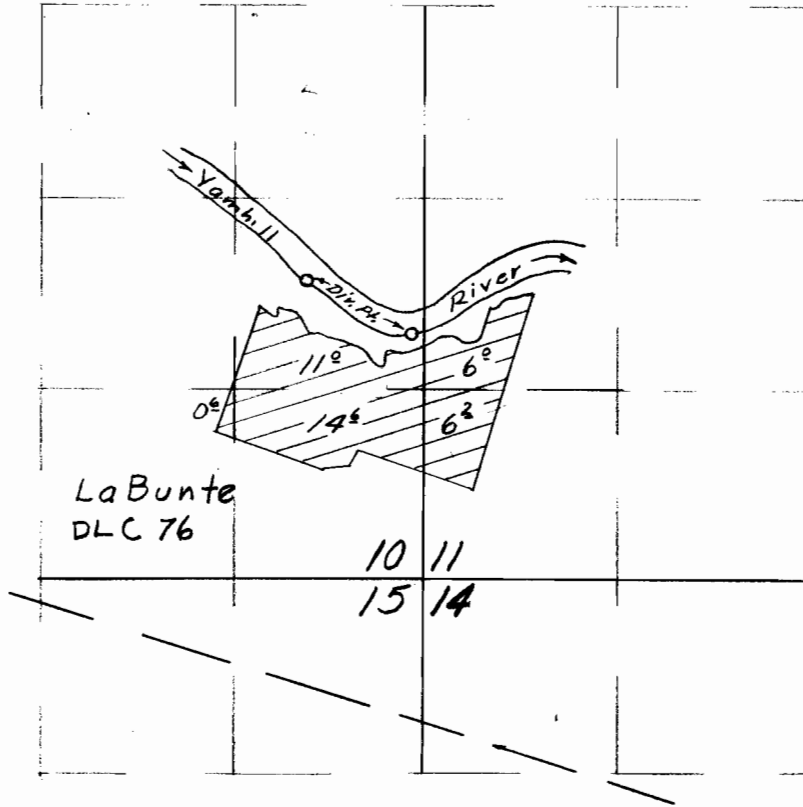

Final Proof Survey
Under

Application No. 21954 Permit No. 17271

In Name OF

Dick Hess

Surveyed June 7 1955 by T. Jones