


T. 2 N. R. 3 W. W.M.

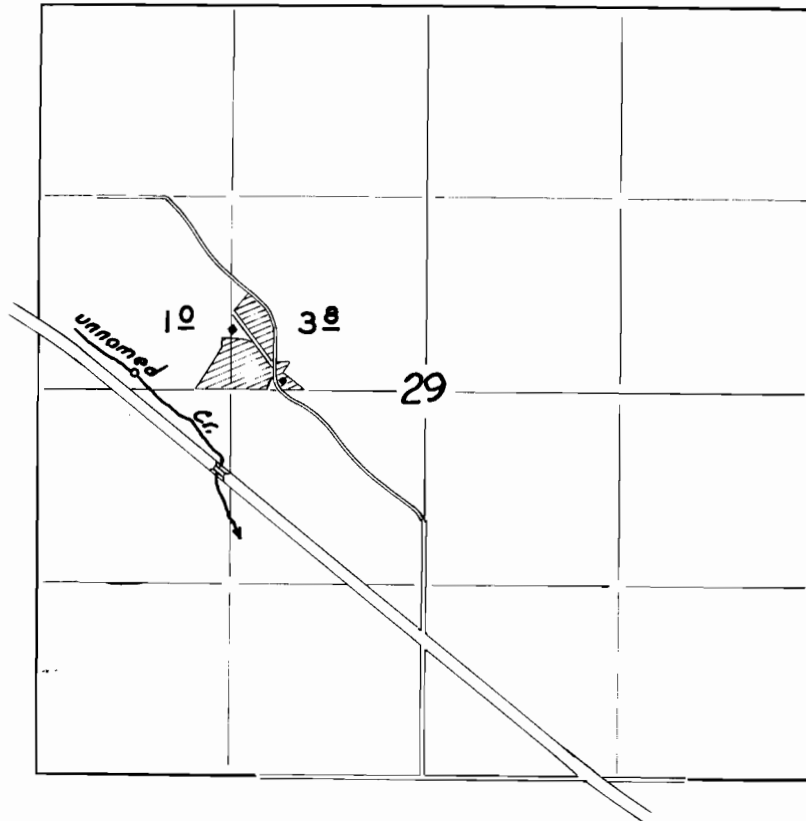

FINAL PROOF SURVEY

UNDER

Application No. 21994 Permit No. 17293
IN NAME OF

CHARLES C. HARRIS

Surveyed 4 - 18 1956, by R.H. WHITBY.