


T.2 S., R.2 W., W.M.

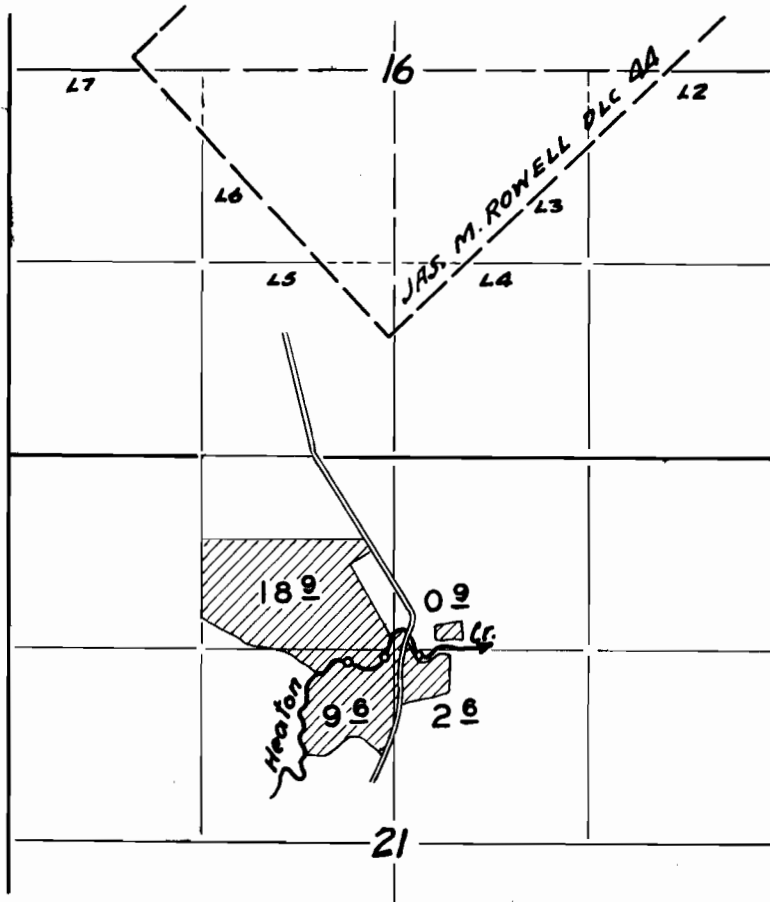

**FINAL PROOF SURVEY**

UNDER

Application No. 2234 | Permit No. 17616

IN NAME OF

RALPH E. & DORIS STOREY HIATT

Surveyed 5 - 2 1956 by M. BISH