


T4SR8WWM

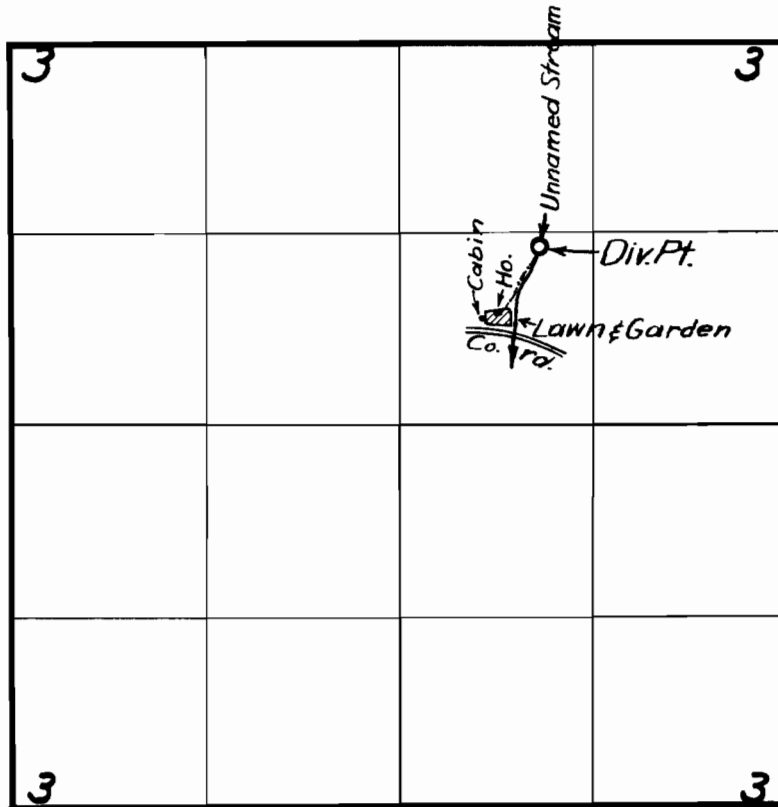

FINAL PROOF SURVEY

UNDER
22501 17907

Application No. 23684 Permit No. 18709.

IN NAME OF

LEE TAYLOR

Surveyed Aug 12 1955, by *M. Bush*