


T.37 S.R.14&15 W.WM

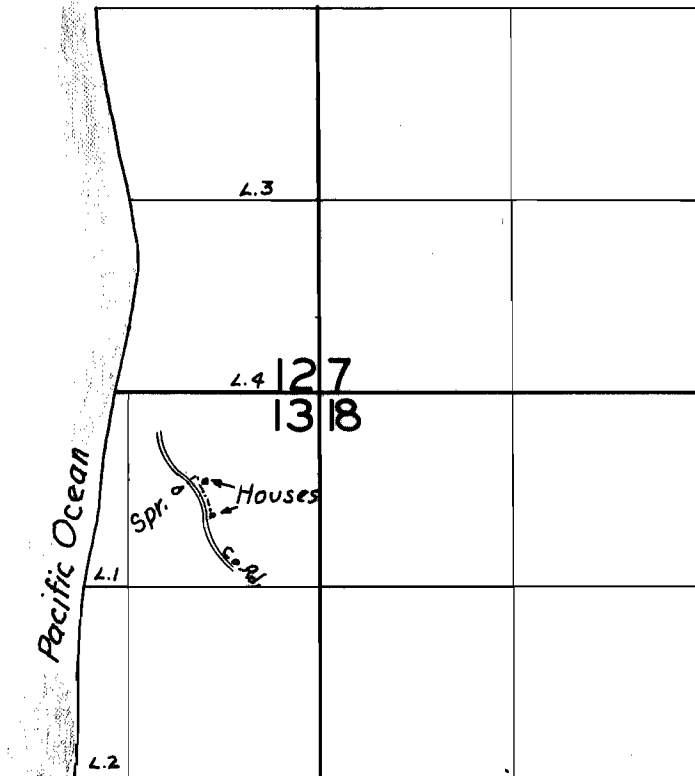

FINAL PROOF SURVEY UNDER

Application No. 22545..... Permit No. 17756.....
IN NAME OF

Charles W. and Claire P. Graham

Surveyed Sept. 15, 1953, by T. Jones

1953-Y