


T. 9S. R. 5W. W.M.

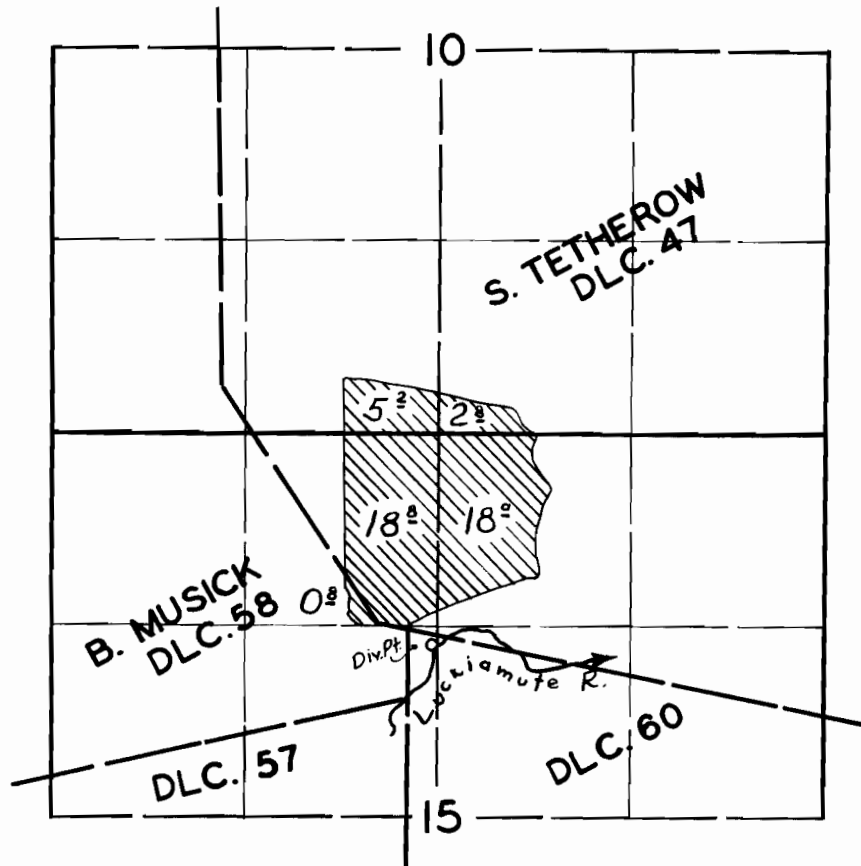

FINAL PROOF SURVEY

UNDER

Application No. **23422** Permit No. **18567**

IN NAME OF

MALCOLM H. ARMOUR

Surveyed *16 Aug. 1956*, by *R. H. Whitby*