


T. 9 S. R. 21 E. W.M.

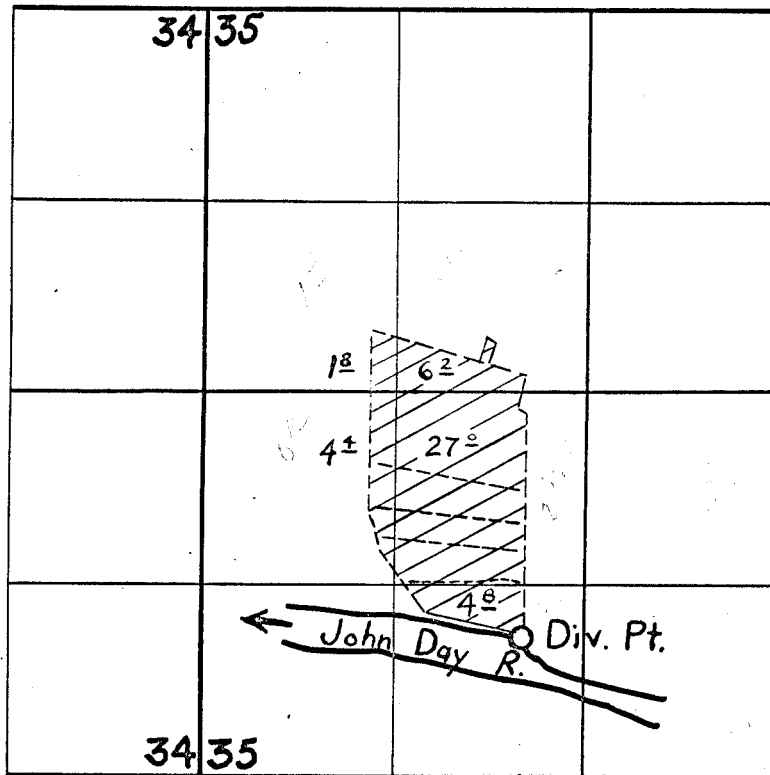

FINAL PROOF SURVEY
UNDER

Application No. 23552 Permit No. 18597
IN NAME OF

R. S. WILLIAMS

Surveyed 21 Apr. 1955, by T. Jones

DOV-10H-98