


T. 1 N. R. 3 W. W.M.

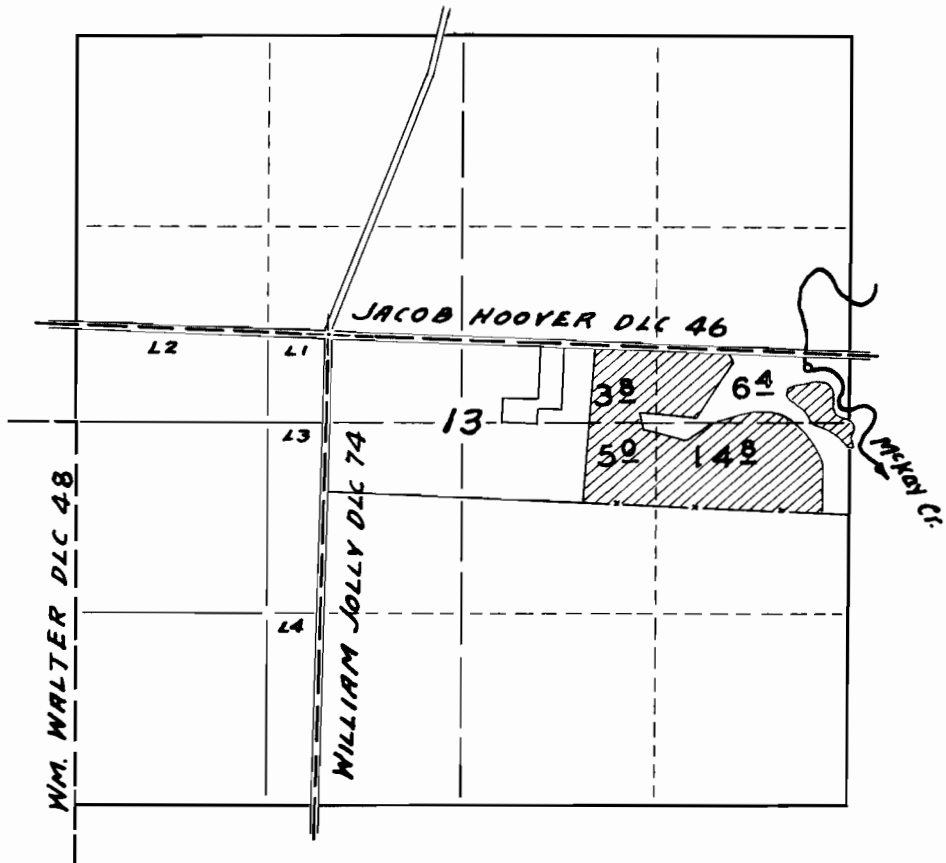

FINAL PROOF SURVEY

UNDER

Application No. 23604 Permit No. 18616

IN NAME OF

JULIA BERGGREN

Surveyed 4-24-1956, by R.H. WHITBY