


T4SR8WWM

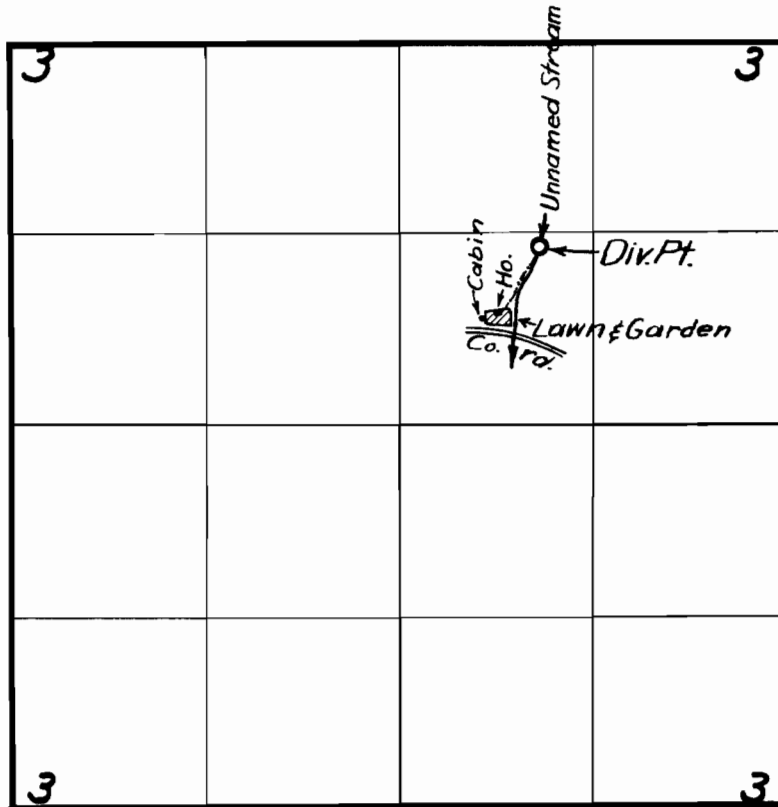

**FINAL PROOF SURVEY**

UNDER  
22501 17907

Application No. 23684 Permit No. 18709.

IN NAME OF

**LEE TAYLOR**

Surveyed Aug 12 1955, by *M. Bish*