


T. 1 S., R. 2 W., W.M.

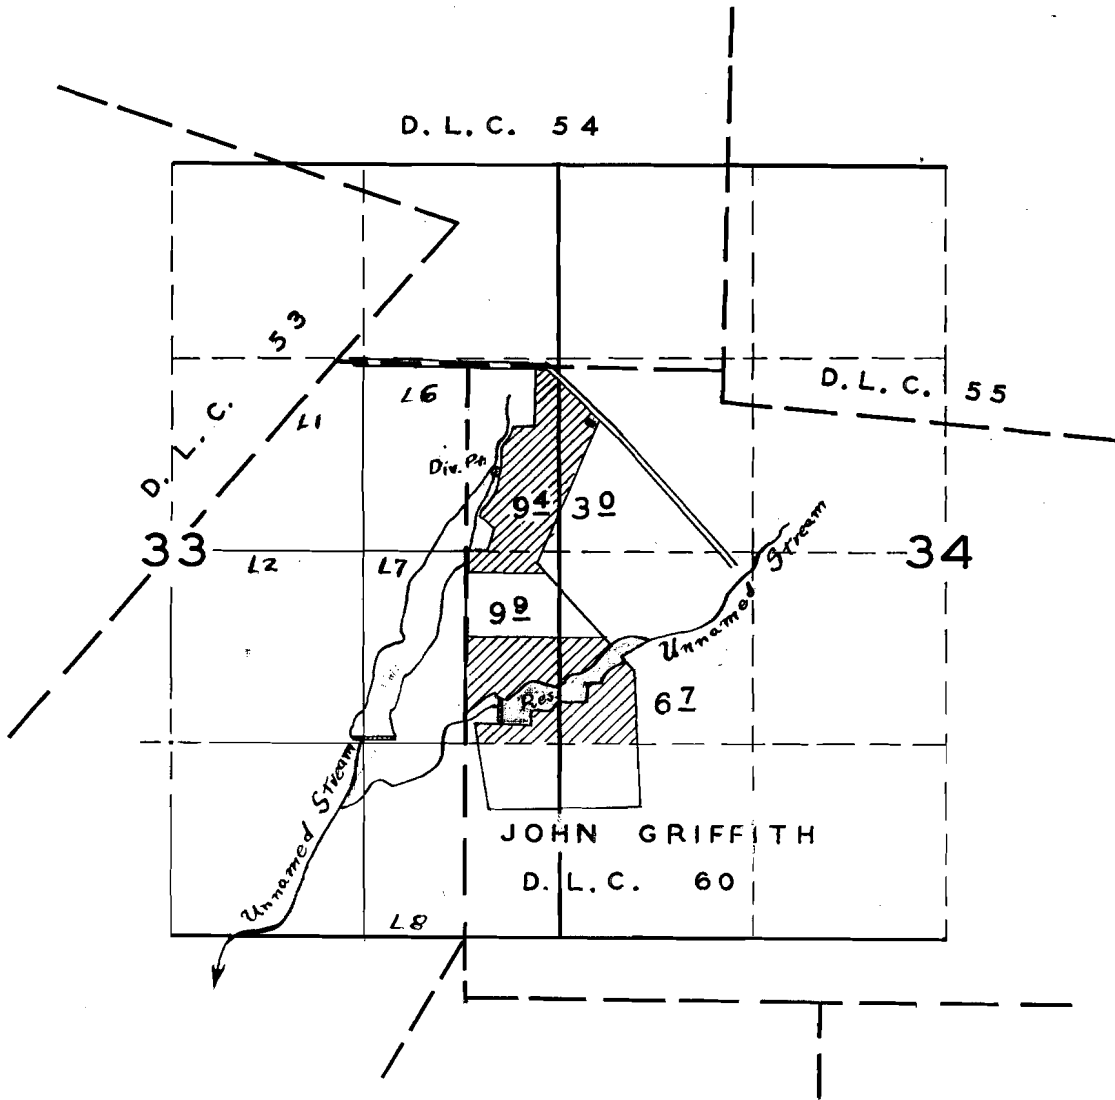

FINAL PROOF SURVEY

23690 UNDER 18713

R-25883 R-1212

Application No. 25884 Permit No. 20534

IN NAME OF

CLARENCE LINDOW

Surveyed 5 - 8 1956, by M. BISH