


T. 4S. R. 2E. W.M.

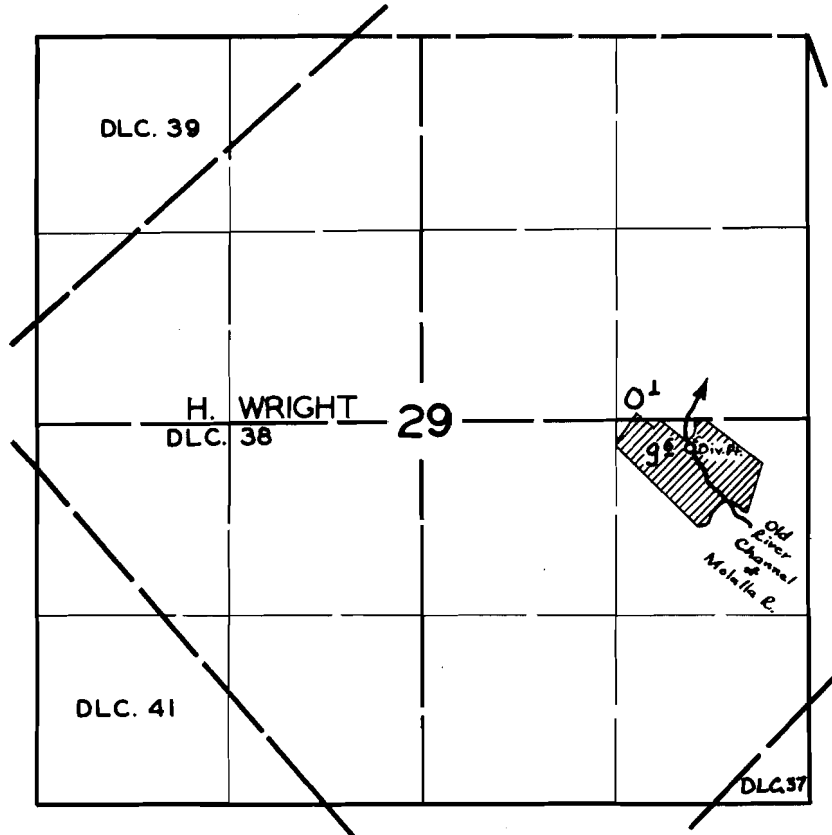

FINAL PROOF SURVEY
UNDER

Application No. 23951 Permit No. 19184
IN NAME OF

ALFRED T. WRIGHT

Surveyed 12 Mar. 1956, by R. D. Best

DFK-3D-119

200