


T. 1 N., R. 1 W., W. M.

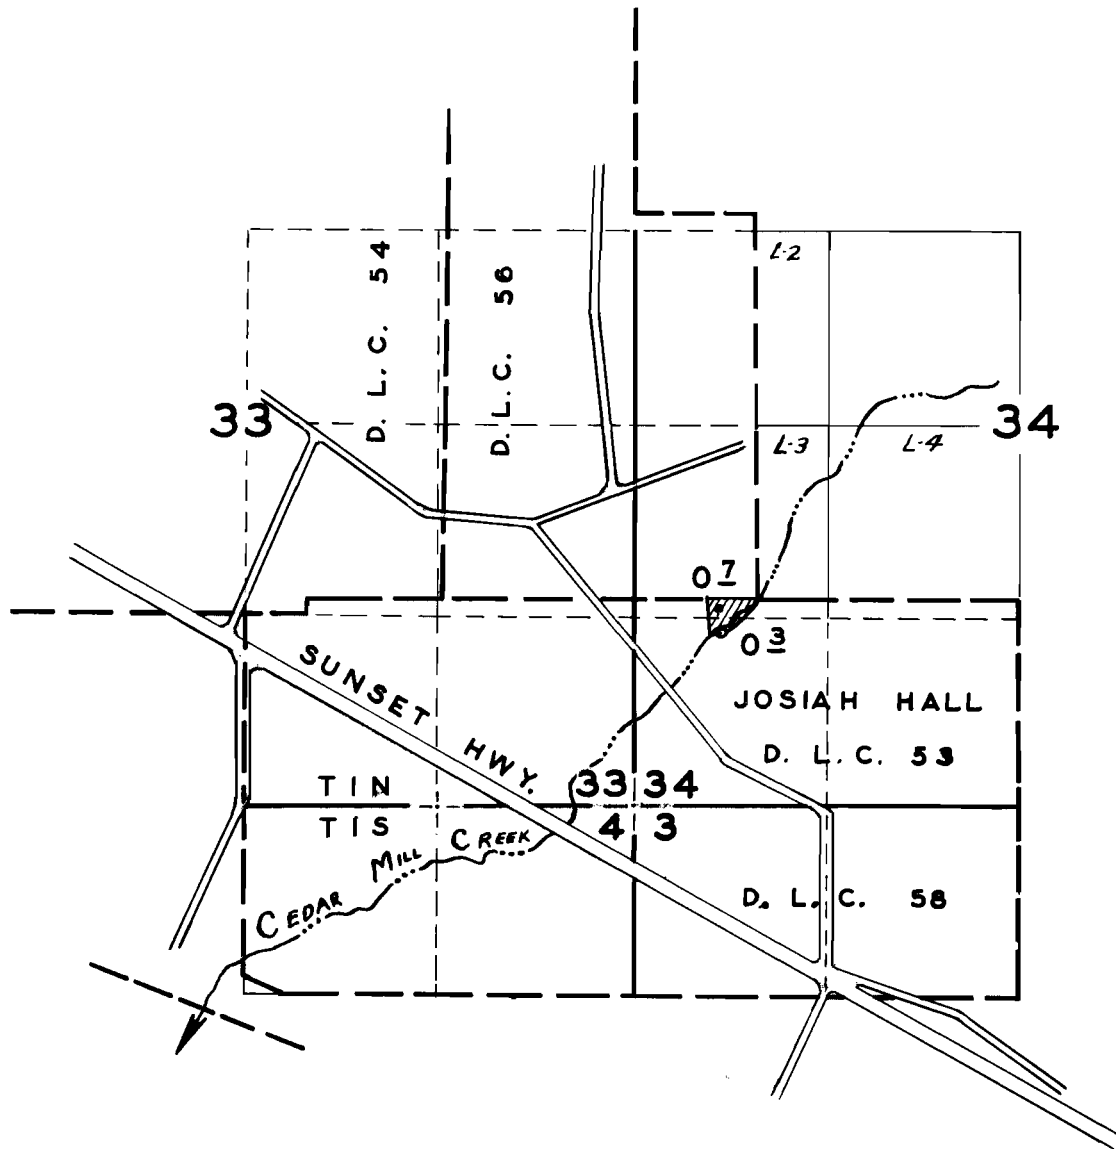

FINAL PROOF SURVEY

UNDER

Application No. 24095 Permit No. 18973

IN NAME OF

GEORGE E. OLSON

Surveyed 4 - 9 1956 by M. BISH