


T. 2 S. R. 3 E. W.M.

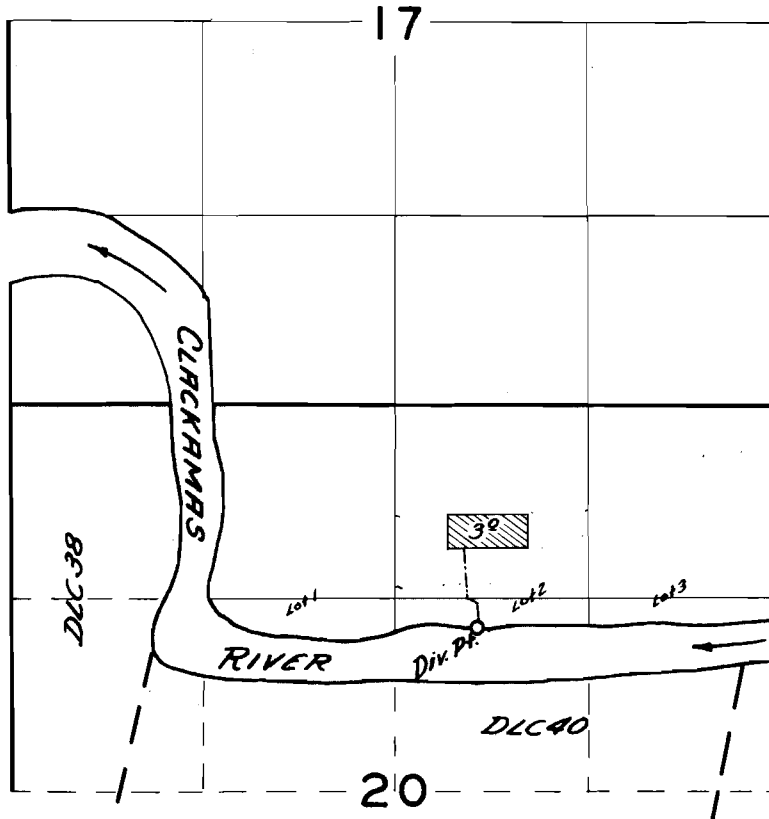

FINAL PROOF SURVEY
UNDER

Application No. *24151*..... Permit No. *19003*.....
IN NAME OF

E. RAY & FLORENCE B. BERDAN.....

Surveyed *June 29*.. 1956., by *R.H. Writby*.....

DPK-10-135

C.B.