2344 36481 D-3638

orrectly Represents the works described in the accompanying appli
elocation of Streams and other ditches in the immediate

S Wright
Sur

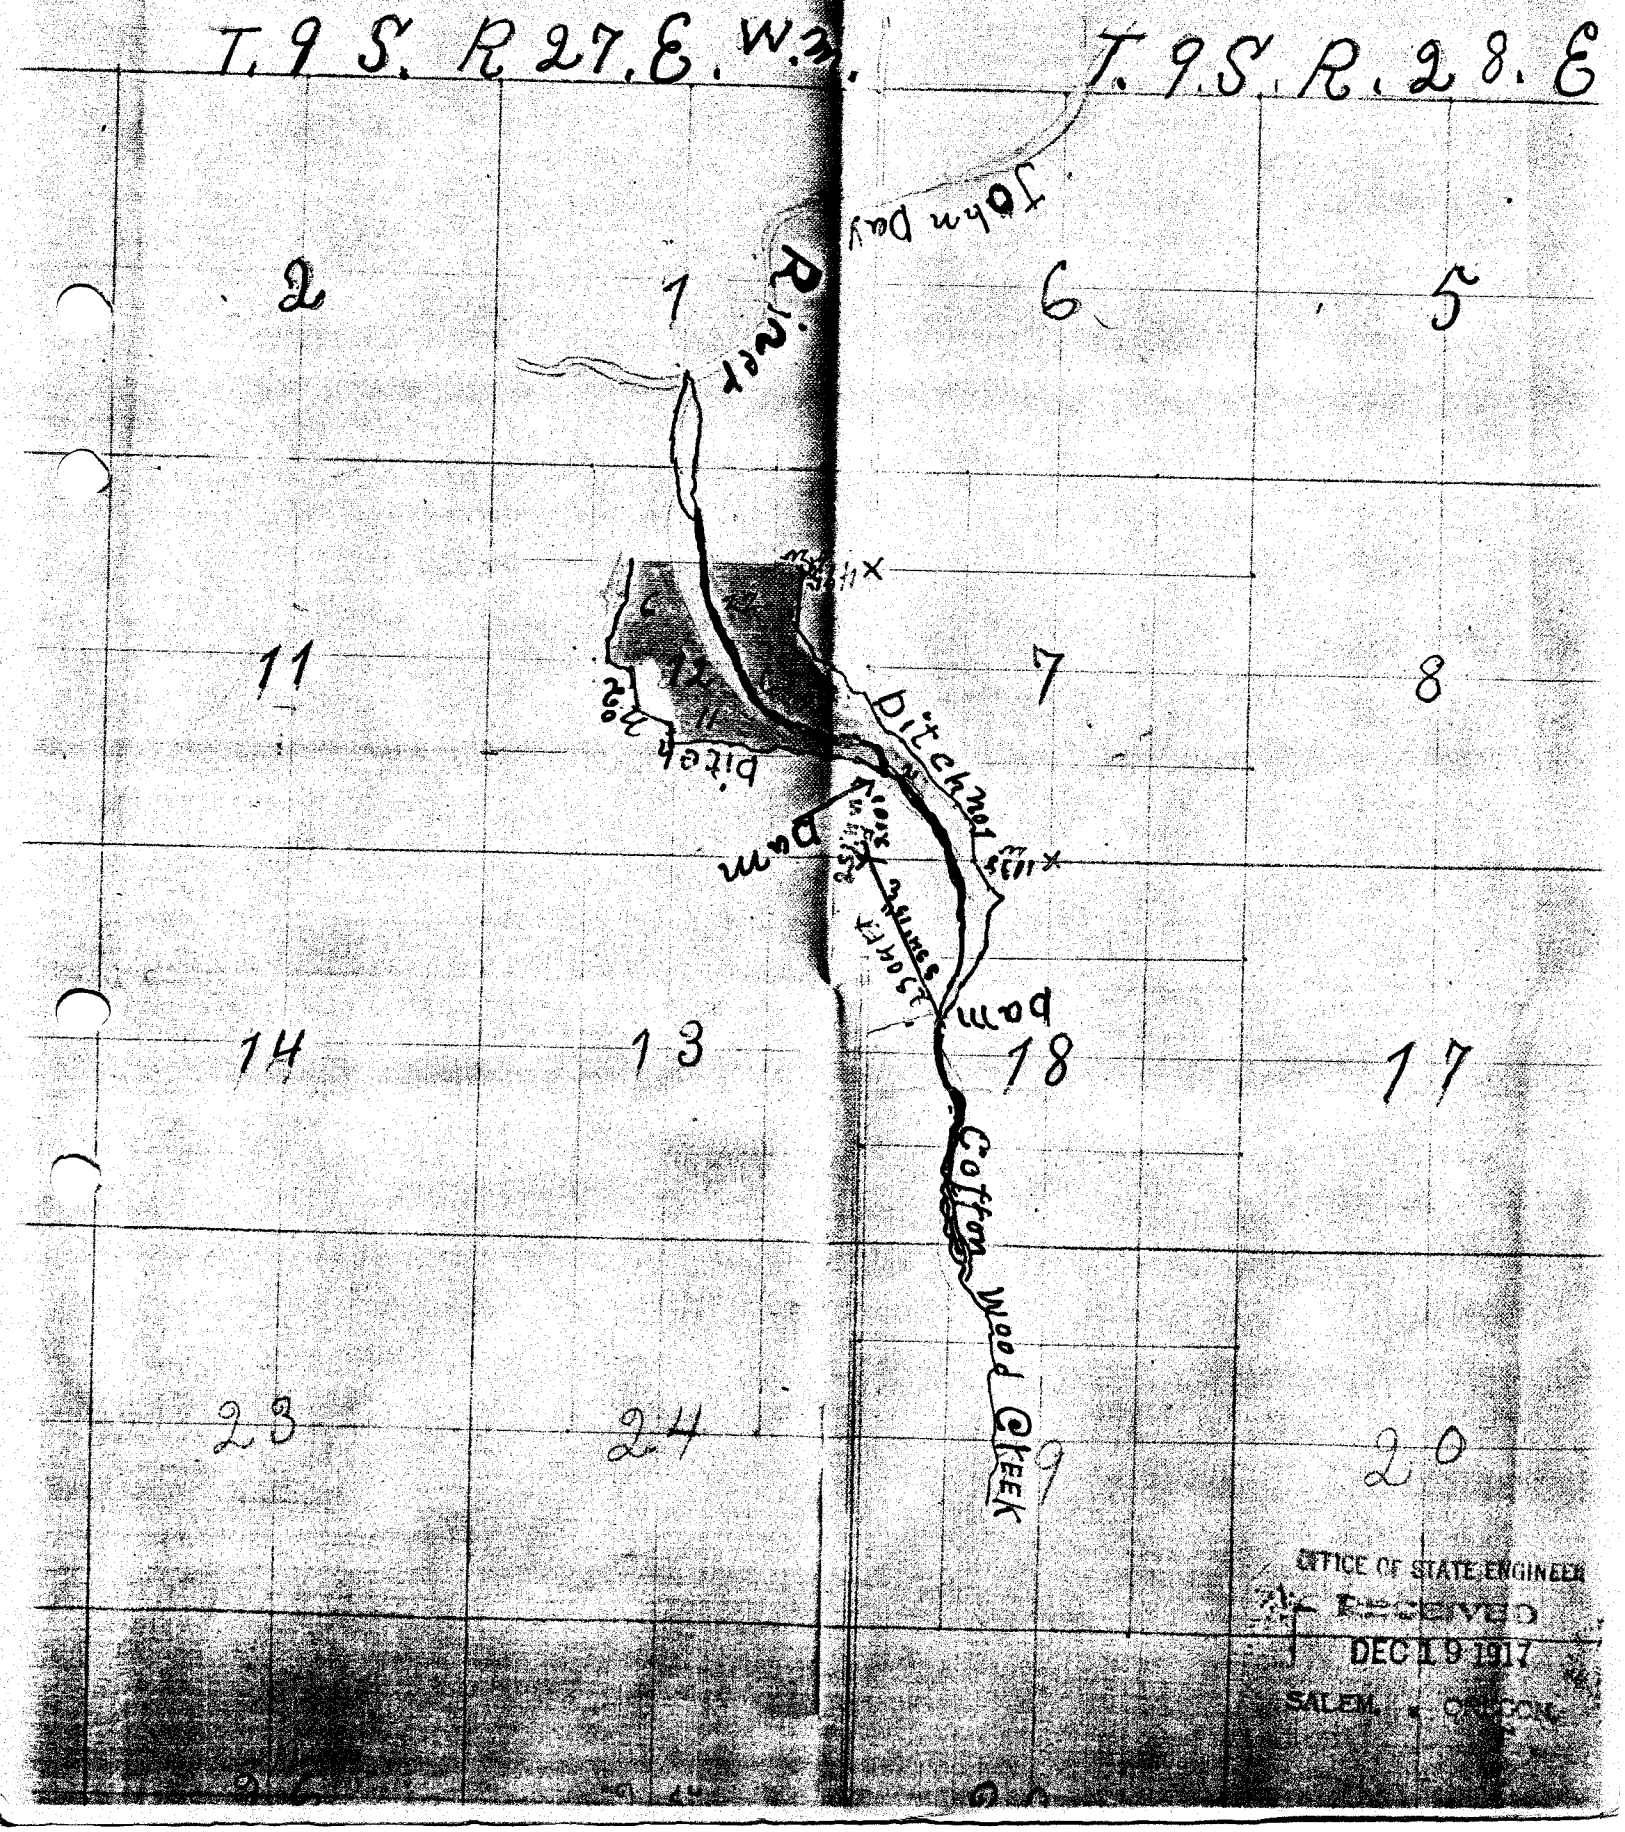

OFFICE OF STATE ENGINEER
RECEIVED
DEC 19 1917
SALEM, OREGON