


T. 3 N. R. 2 W. W.M.

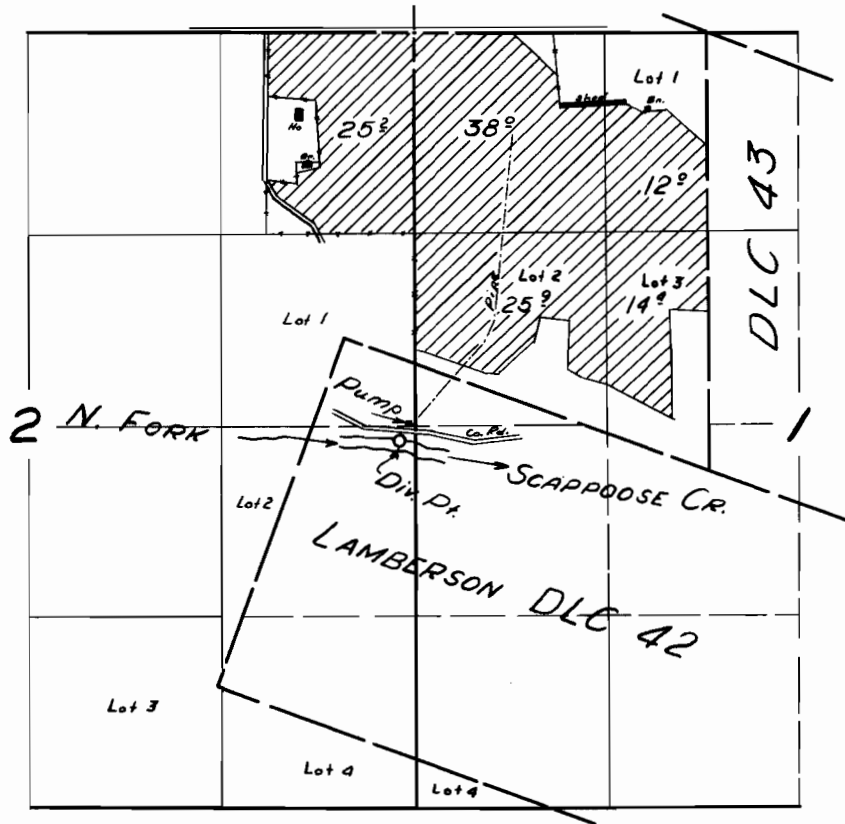

FINAL PROOF SURVEY
UNDER

Application No. 24158 Permit No. 19080
IN NAME OF

E "MIKE" DERING

Surveyed 18 July 1956, by [Signature]