


T. 1 N., R. 1 W., W. M.

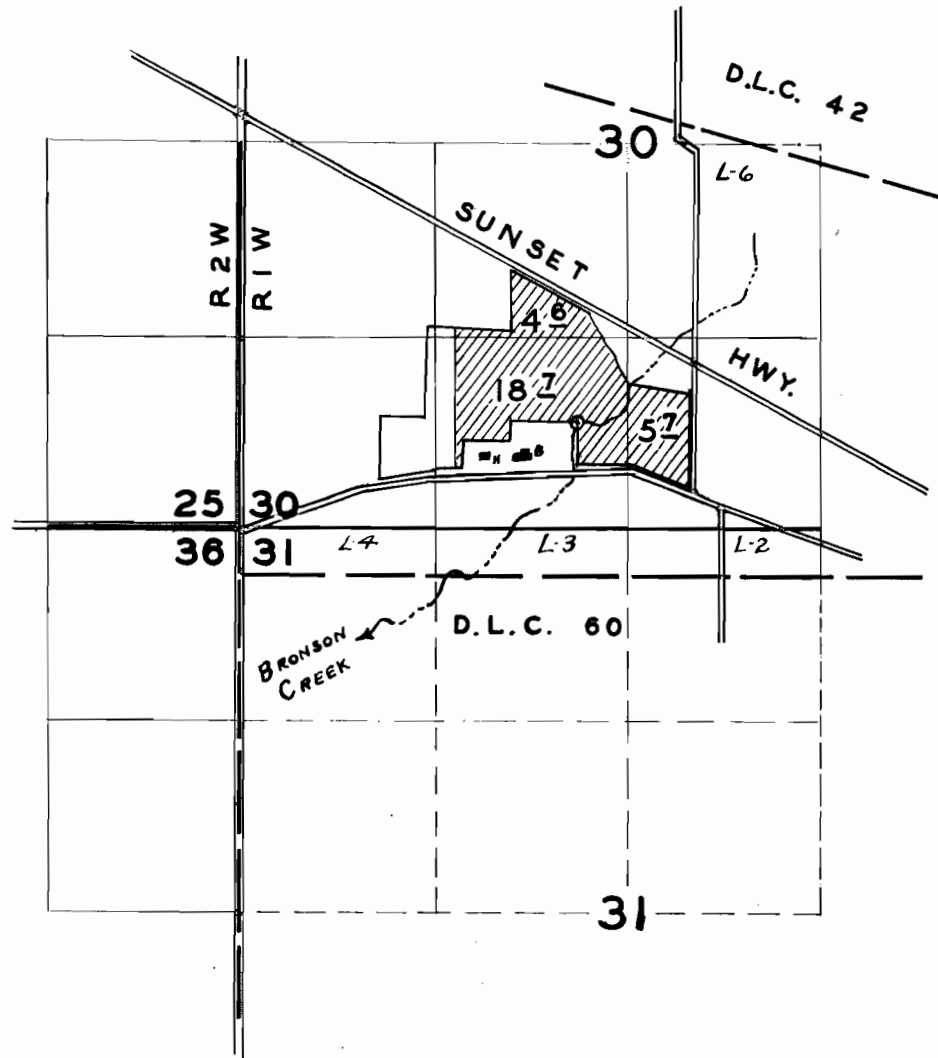

**FINAL PROOF SURVEY**

UNDER

Application No. 24264 Permit No. 19044

IN NAME OF

ALBERT &/OR DONALD MEIER

Surveyed 4 - 17 1956, by M. BISH