


T.2N., R.3W., W.M.

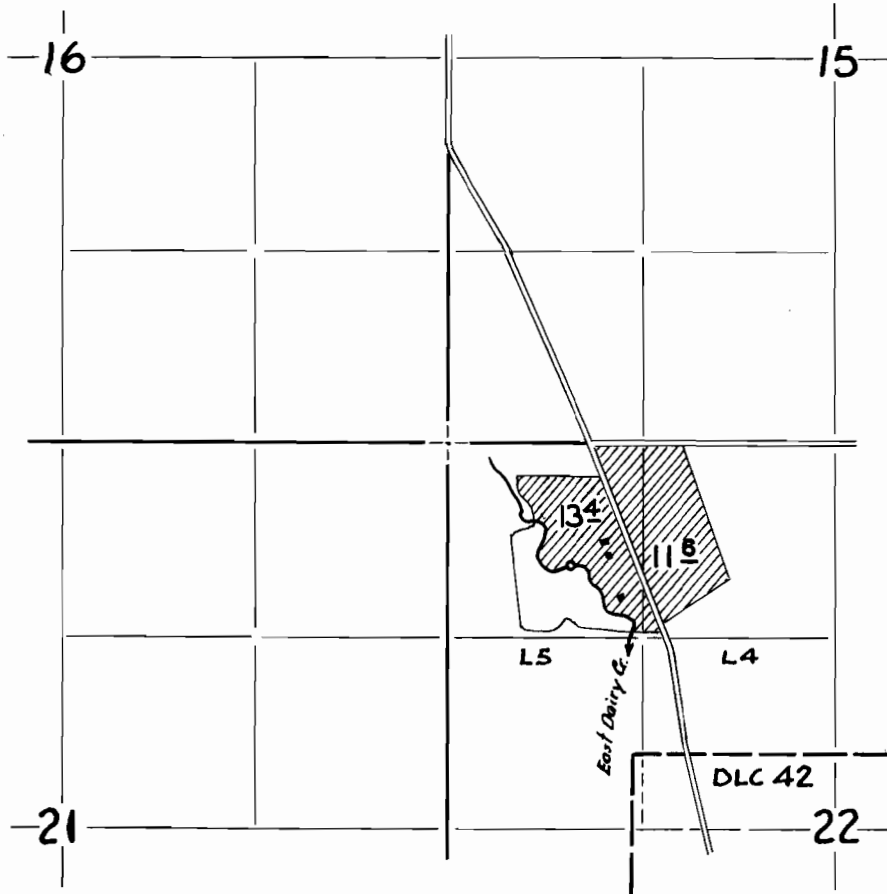

FINAL PROOF SURVEY

UNDER

Application No. 24316 Permit No. 19060

IN NAME OF

MR. & MRS. RAYMOND C. LYNN

Surveyed 4 - 11, 1956, by R. H. WHITBY