


T.2S. R.1W. W.M.

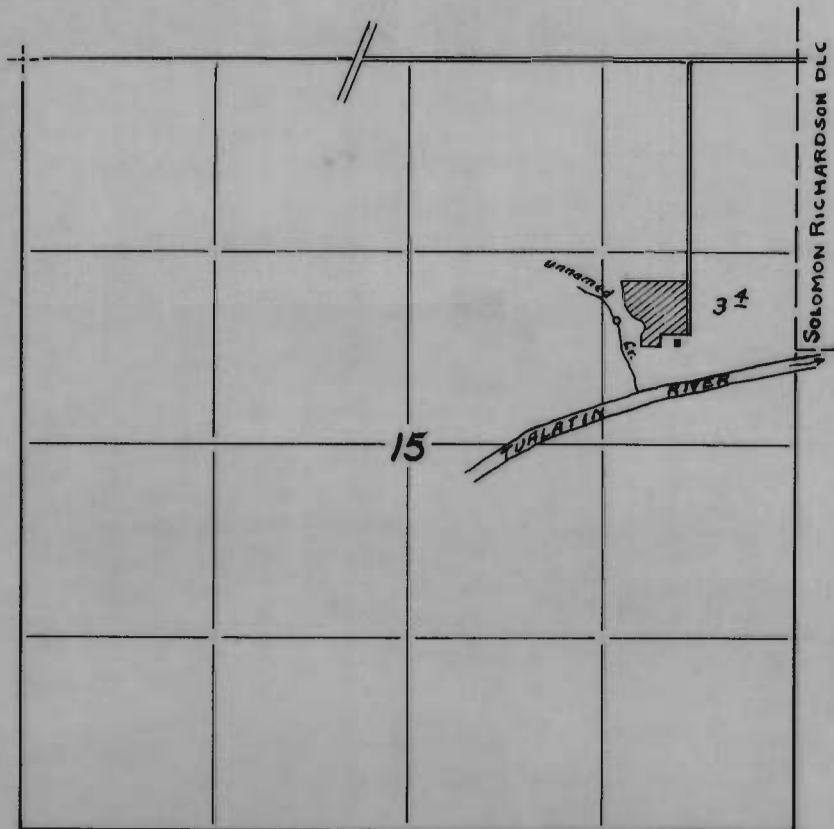

FINAL PROOF SURVEY

UNDER

Application No. 24069 Permit No. 19197

IN NAME OF

R.E. OGLE

Surveyed 5 - 8 1956, by R.H. WHITBY