


T.1N., R.3W., W.M.

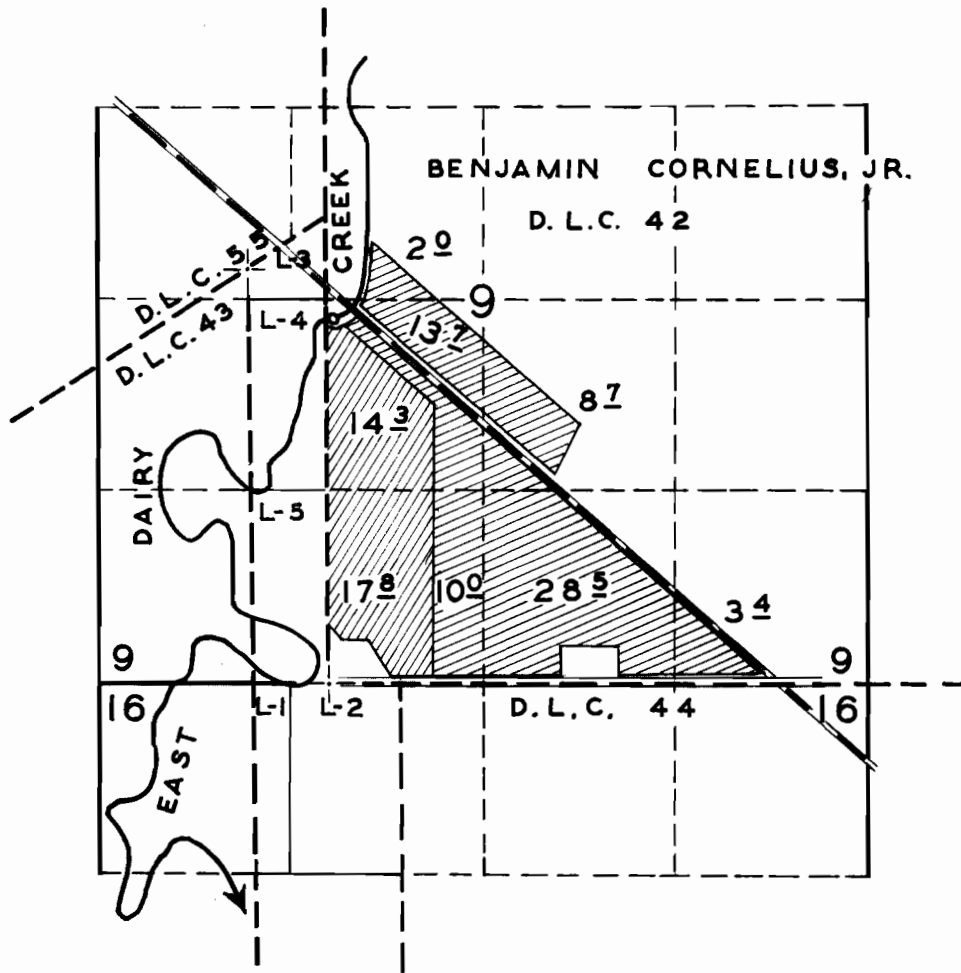

FINAL PROOF SURVEY

UNDER
24417 19160

Application No. 24418 Permit No. 19161



IN NAME OF
ALFRED E. & ELMER G. DELPLANCHE
LAWRENCE E. DELPLANCHE

Surveyed 4-16 1956 by R.H. WHITBY