


T. 1 S., R. 2 W., W.M.

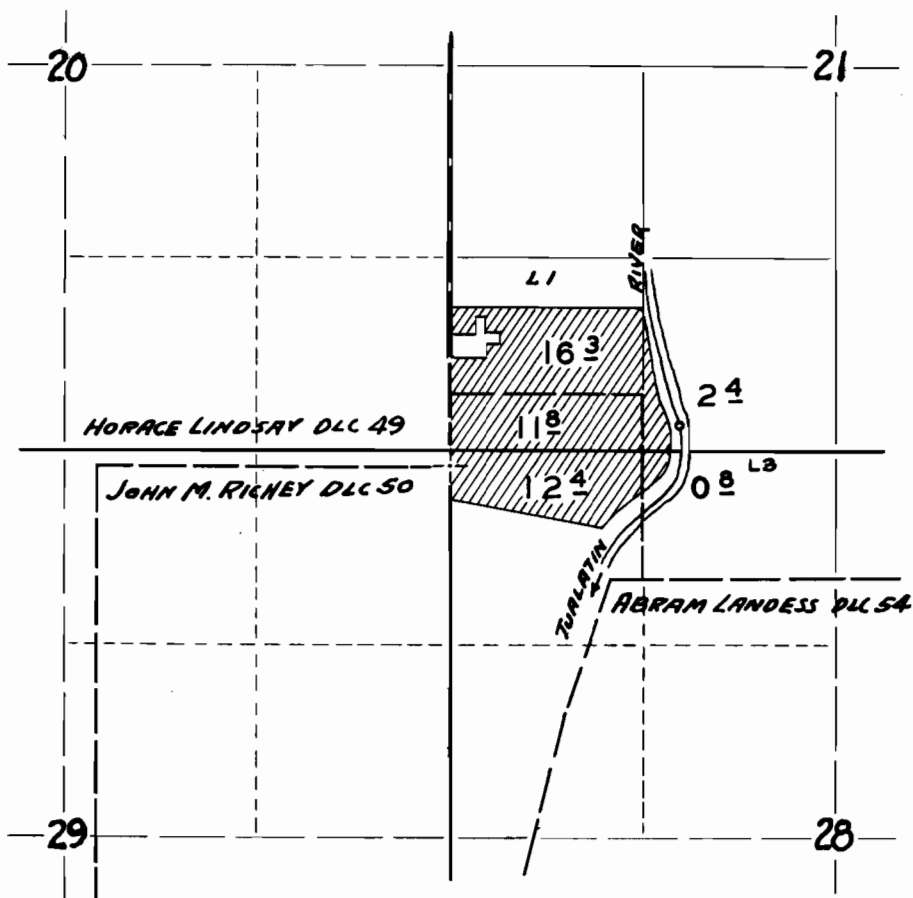

FINAL PROOF SURVEY

UNDER

Application No. 24427 Permit No. 19261

IN NAME OF

MARVIN HERMENS

Surveyed 4 - 19 1956, by M. BISH