


T. 4S. R. 1W. W.M.

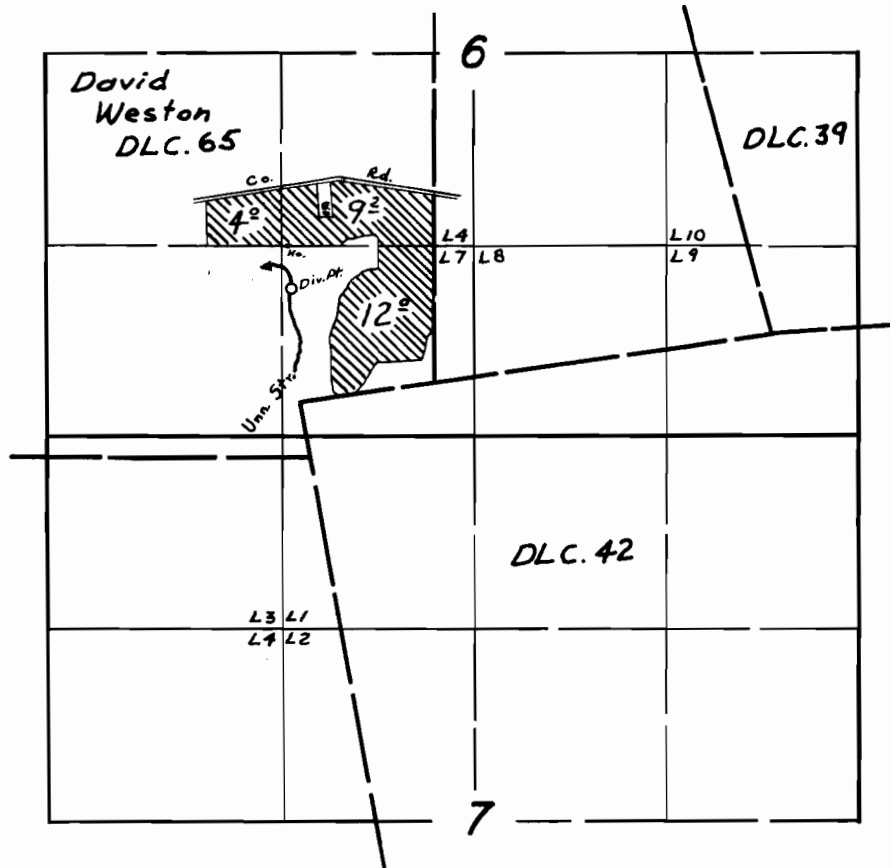

**FINAL PROOF SURVEY**

UNDER

Application No. 24440 Permit No. 19270

IN NAME OF

CLIFFORD E. PAHL

Surveyed 25 Sept 1956, by M. Bish

*RB*