


T. 5S. R. 2E. WM.

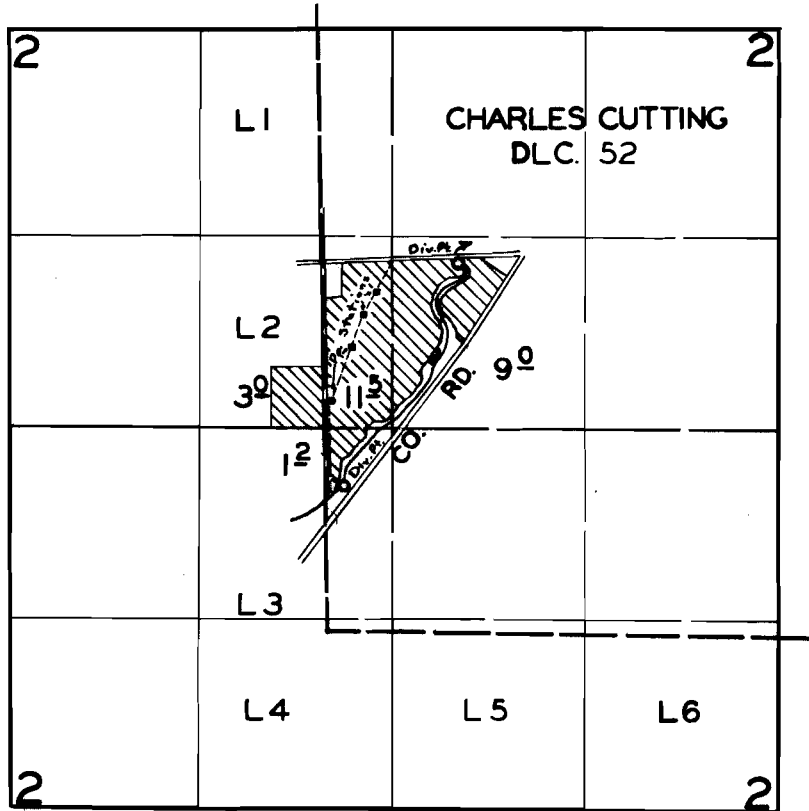

FINAL PROOF SURVEY

UNDER

Application No. **24458** Permit No. **19280**

IN NAME OF

GLENE & JEANE OLSON

Surveyed **15 MAR. 1956**, by **R.D. BEST**