


T.2S.,R.1E.,W.M.

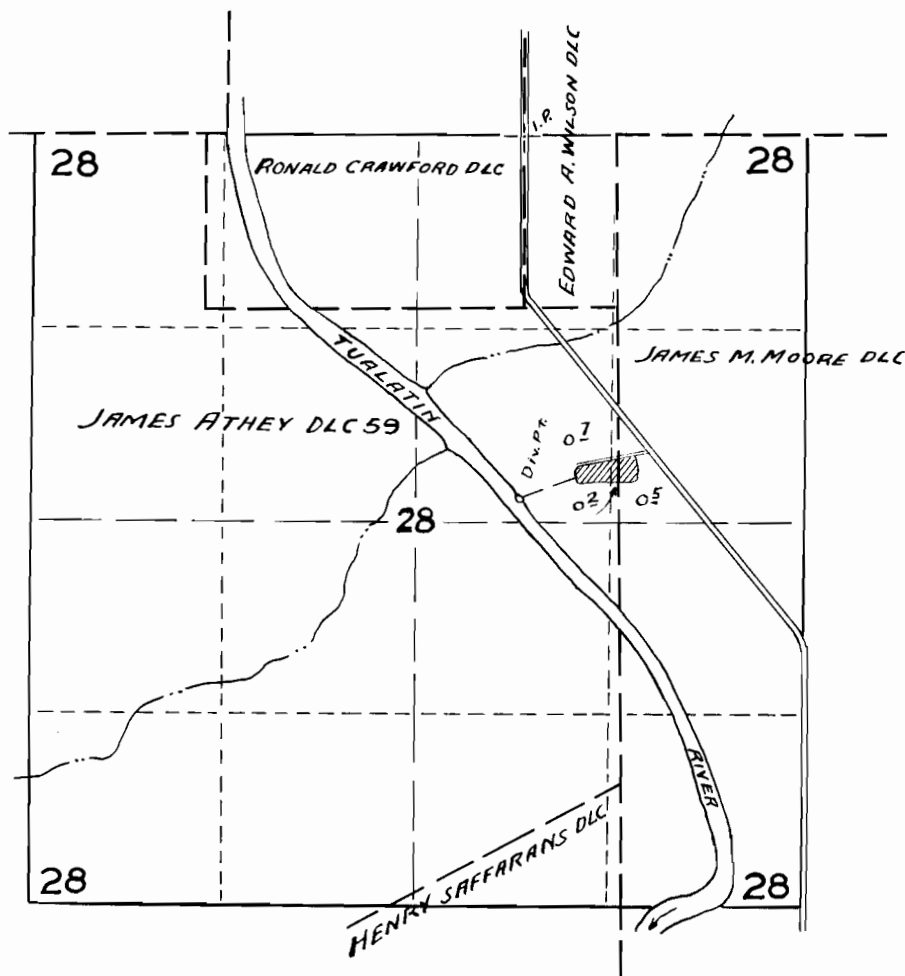

FINAL PROOF SURVEY
UNDER

Application No. 25020 Permit No. 19712
IN NAME OF

JAMES & LETA V. KUHR

Surveyed 5-7 1956, by R.D. BEST.