


T.2S., R.2W., W.M.

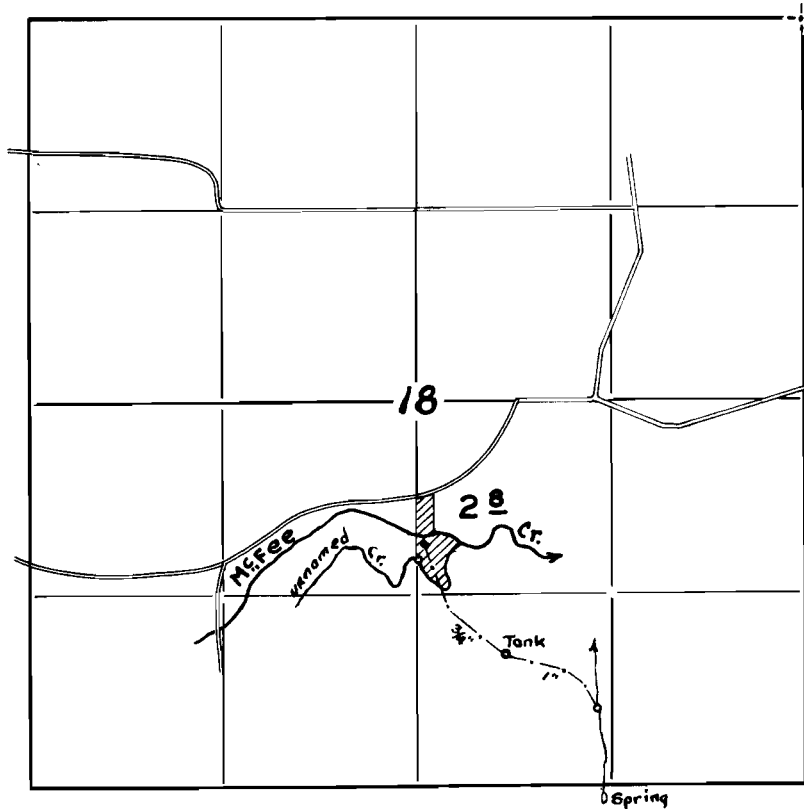

FINAL PROOF SURVEY

UNDER

Application No. 25417 Permit No. 20216

IN NAME OF

JAMES H. PATTERSON

Surveyed 5 - 5 1956, by M. BISH