


T. 7 N R. 2 W W.M.

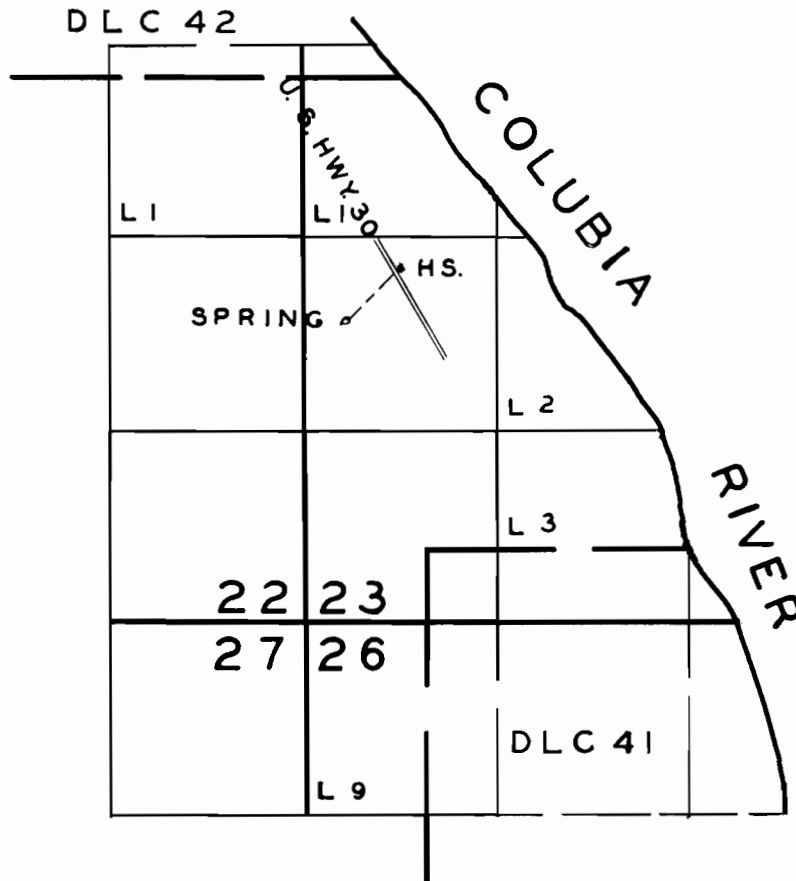

**FINAL PROOF SURVEY**

UNDER

Application No. 22 900 Permit No. 20180

IN NAME OF

*Fred G. Klein et al*

Surveyed AUG. 22 1956, by R. H. WHITBY