


T. 3S. R. 2E. W.M.

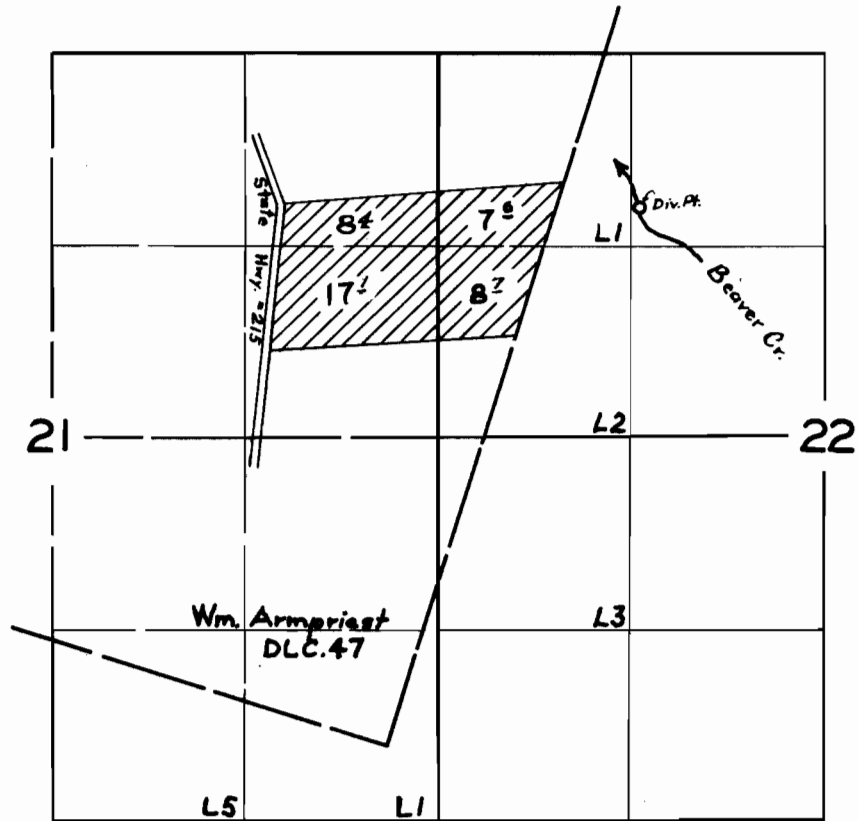

**FINAL PROOF SURVEY**

UNDER

Application No. 26291 Permit No. 20636

IN NAME OF

W. H. Fisher

Surveyed 21 June 1956, by M. Bish

DFK-3D-151

2065