


T.5N.R.1W.W.M.

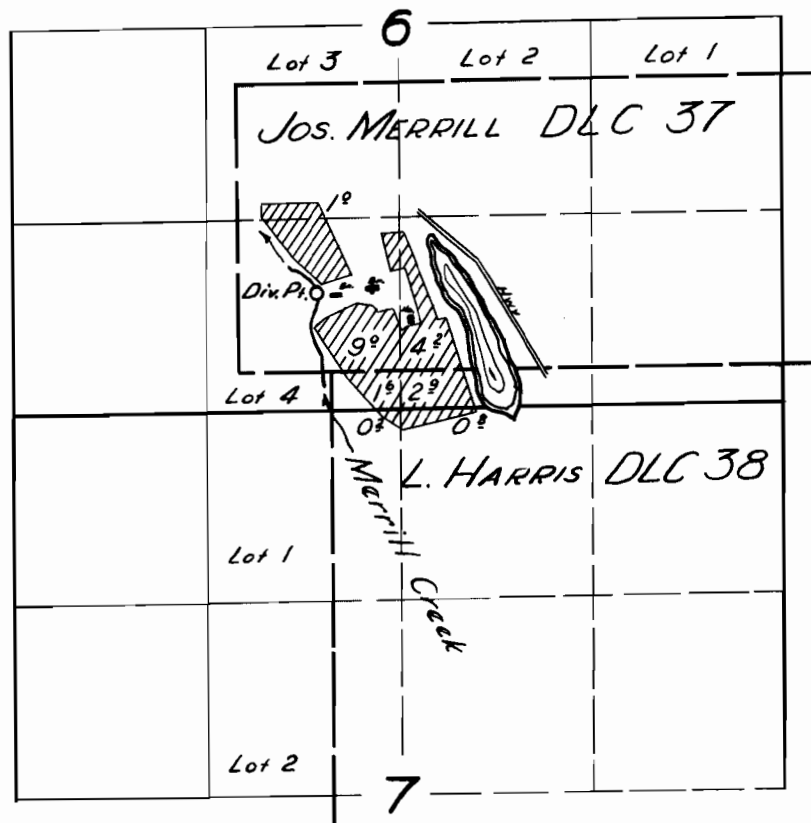

FINAL PROOF SURVEY
UNDER

Application No. 24386 Permit No. 19238
IN NAME OF

E. L. WORKMAN

Surveyed 4 Aug. 1956, by R. B. Shelby