


T. 1 S., R. 2 W., W.M.

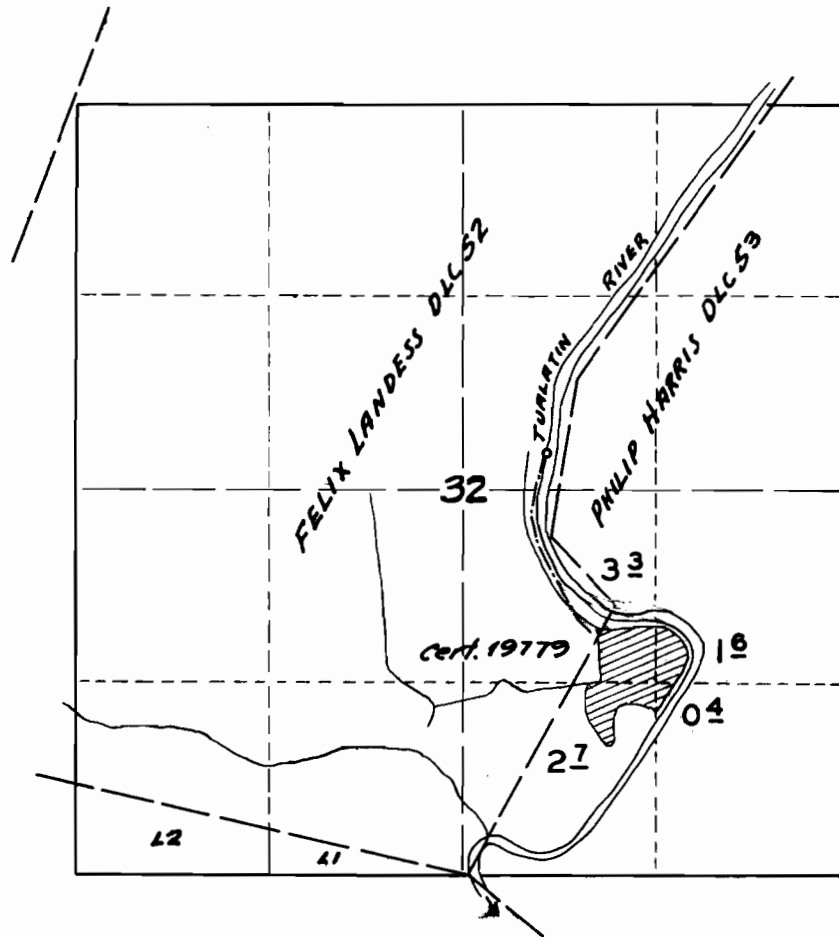

FINAL PROOF SURVEY

UNDER

Application No. 24404 Permit No. 19642
IN NAME OF

W. T. PUTNAM & SONS

Surveyed 4 - 20 1956, by M. BISH