


T.3S. R.2 W. W.M.

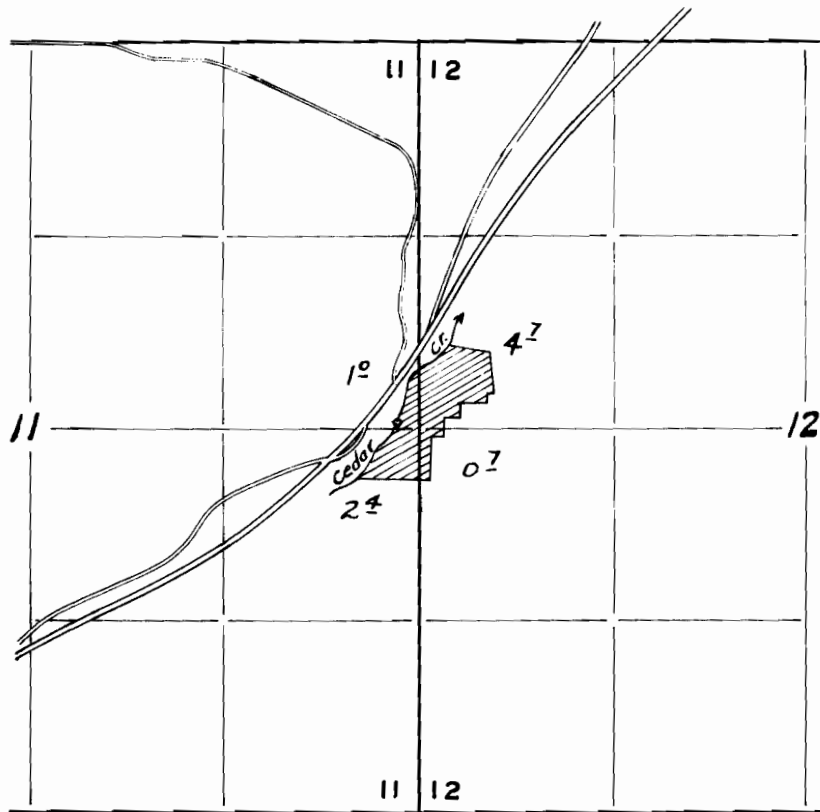

FINAL PROOF SURVEY

UNDER

Application No. 26418 Permit No. 21000
IN NAME OF

T. G. SANDERS

Surveyed 5-3-1956, by R.H. WHITBY