


T. 1 S., R. 2 W., W.M.

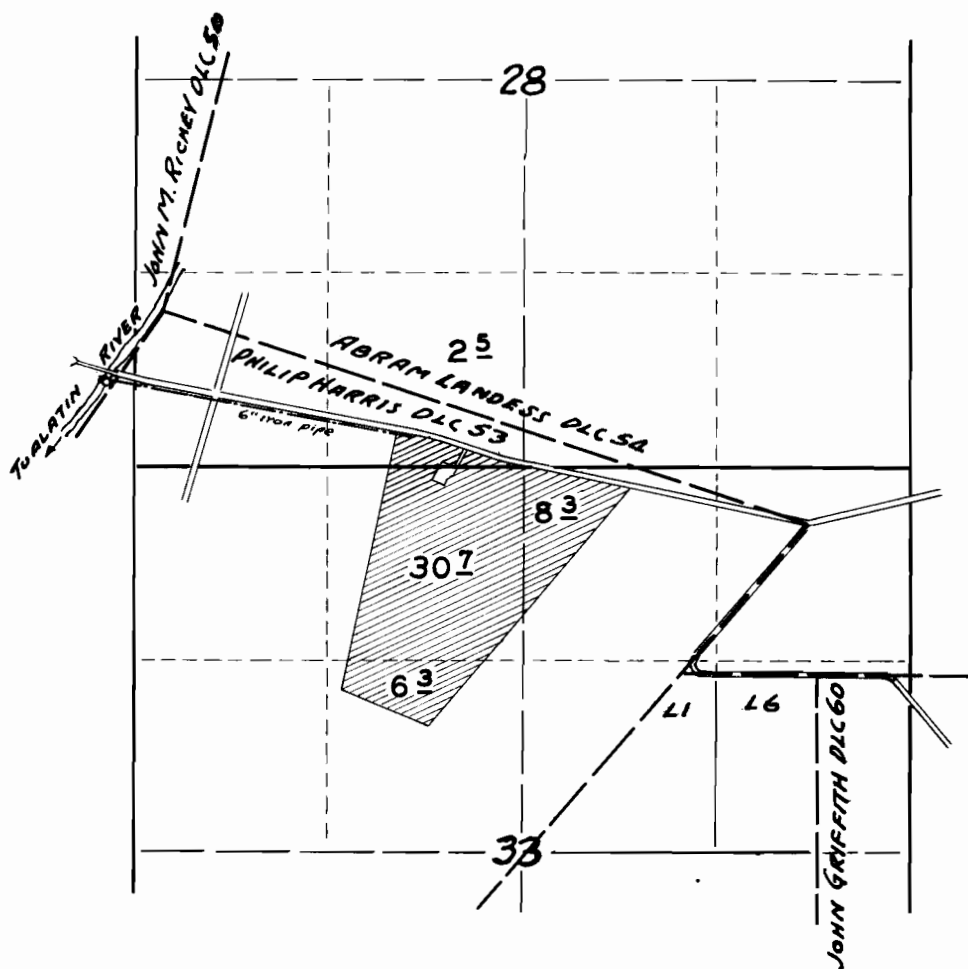

**FINAL PROOF SURVEY**

UNDER

Application No. 24491 Permit No. 21498

IN NAME OF

LOYAL L. DAVIS

Surveyed 4 - 20 1956, by M. BISH