


T. 1 N., R. 1 W., W. M.

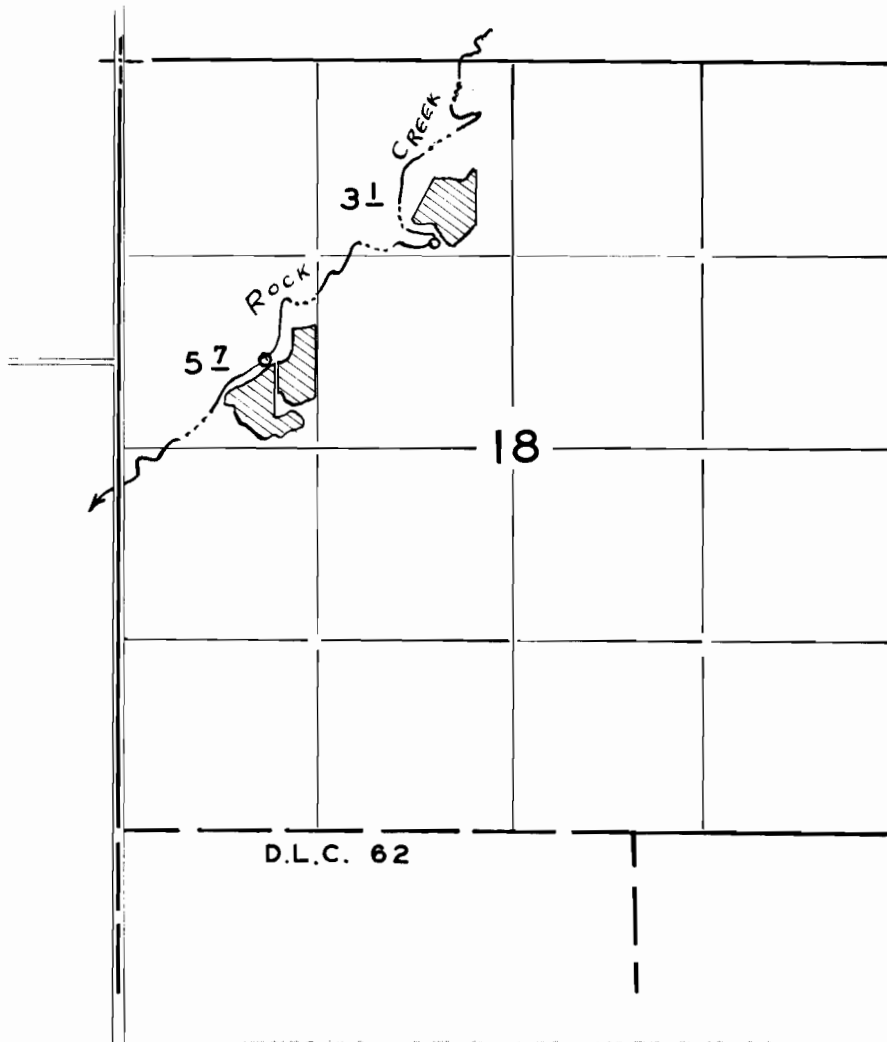

FINAL PROOF SURVEY
UNDER

Application No. 24571 Permit No. 19323
IN NAME OF

EUGENE F. BEACH

Surveyed 4 - 10 1956, by M. BISH