


T. 1 S., R. 1 W., W.M.

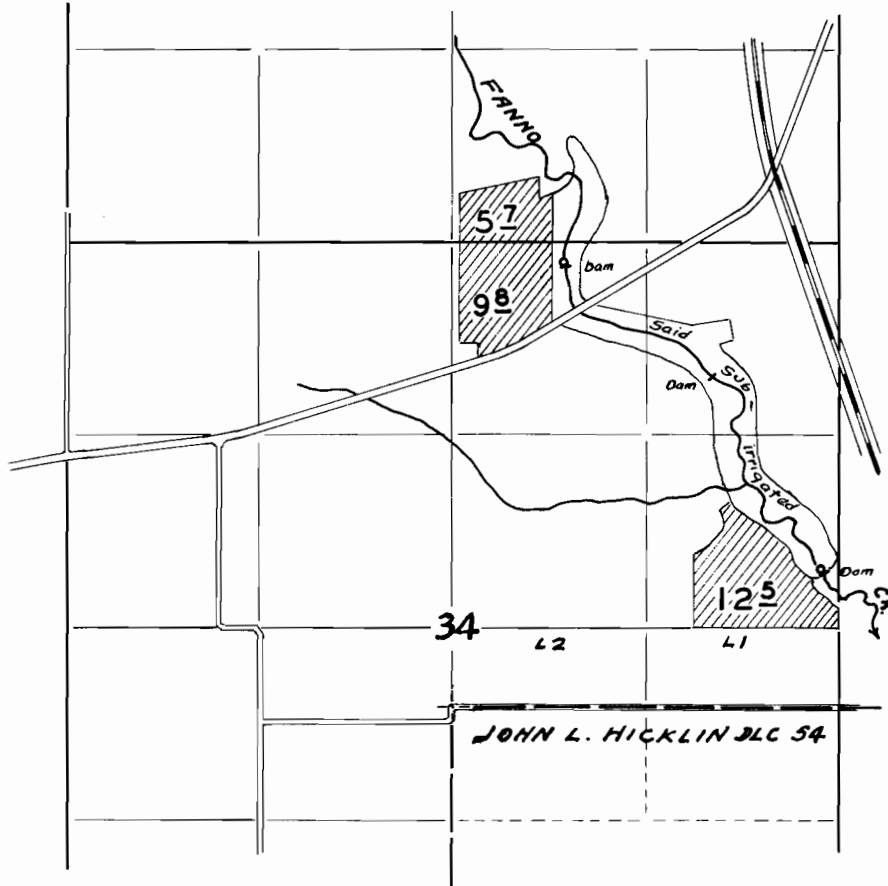

FINAL PROOF SURVEY
UNDER

Application No. 24593 Permit No. 19376
IN NAME OF

C. L. ROBINSON

Surveyed 4 - 17, 1956, by M. BISH